



July 14, 2026

Via E-Mail

Baitong Chen, Air Quality Engineer, bchen@aqmd.gov
Nathaniel Dickel, Senior Air Quality Engineer, ndickel@aqmd.gov
Christina Ojeda, Air Quality Inspector, cojeda@aqmd.gov
South Coast Air Quality Management District
21865 East Copley Drive
Diamond Bar, California 91765-4182

Re: Chiquita Canyon, LLC's Weekly Leachate Inspection Report for Stipulated Order for Abatement (Case No. 6177-4), Condition 27(c)

All:

Pursuant to Condition 27(c) of the Stipulated Order for Abatement with the South Coast Air Quality Management District in Case No. 6177-4, as modified on June 3, 2026 (the "Order"), Chiquita Canyon, LLC ("Chiquita") hereby submits the enclosed compilation of the twice daily leachate seep inspection logs for the period of July 6, 2026 through July 12, 2026.

During this reporting period, Chiquita also conducted and documented an expanded leachate seep inspection of the entire Main Canyon area on the afternoon of July 8, 2026, in accordance with the new Condition 27(b)(ii) of the Order. No leachate seepage or pooling was observed during that inspection, as reflected in the enclosed log for that afternoon. Consistent with modified Condition 27(c), this report also identifies any leachate seepage or pooling observed outside of the Condition 27(b) inspections during the reporting period.

For the week of July 6 through July 12, 2026, leachate seepage was observed on July 7, 2026, at approximately 6:45 a.m., in Grid 94 at the Chiquita Canyon Landfill (the "Landfill"). The specific location of this seep is shown on the maps included in the attachment. Upon discovery of the seep, Chiquita promptly initiated response and mitigation measures, including adding fresh soil to the affected area. This initial response work was completed by approximately 8:00 a.m. on July 7, 2026. Chiquita is also planning to install a seep collector, similar to a leachate toe drain, in the area to prevent future recurrence. The installation is scheduled to begin next week. The seepage was not observed during subsequent inspections conducted that week. The seepage is estimated to have been present for approximately 4 total hours. The total volume of leachate associated with this seepage during that period is estimated to have been up to 5 gallons. The observed area impacted by the seepage was approximately 20 square feet. The saturation of the soil was characterized as "Standing Free Liquid." The odor was characterized as "Moderate."

July 14, 2026

Page 2 of 2

Chiquita is continuing to monitor the previously reported containment area on the west side of the Landfill and to remove liquids, as necessary, using a vacuum truck. Chiquita and its consultants are also continuing to plan, design, and construct a soil buttress on the west side of the Landfill, adjacent to the prior "west slope toe drain project," in response to the continued extrusion of reacted material at certain preferential pathways that daylight on the west slope. The total approximate amount of leachate collected from the west side was 20,475 gallons between July 6 and July 12, 2026.

Chiquita is also continuing to monitor the area between Grids 171 and 172, where previously reported seepage was observed. Chiquita is currently installing a new sump in that area.

Please contact me if you have any questions regarding this matter.

Regards,

Matt Breuer
Environmental Manager
Chiquita Canyon

Attachment: Leachate Inspection Logs from July 6 – July 12, 2026

4050 - Chiquita Leachate Seep/Pooling Inspection

6 Jul 2026 / Tom Roe

Complete

Conducted on

6 Jul 2026 6:56 AM PDT

Prepared by

Tom Roe

Leachate Seep Inspection

Leachate seep/pooling Inspection

Leachate seep/pooling Inspection 1

Has a leachate seep/pooling been located?

No



Photo 1

Description of area in photo where there is no leachate seepage or pooling.

Westside perimeter road. None of the seepage previously observed in this area or or 171/172 was observed at the time of this inspection.

4050 - Chiquita Leachate Seep/Pooling Inspection

6 Jul 2026 / Tom Roe

Complete

Conducted on

6 Jul 2026 2:16 PM PDT

Prepared by

Tom Roe

Leachate Seep Inspection

Leachate seep/pooling Inspection

Leachate seep/pooling Inspection 1

Has a leachate seep/pooling been located?

No

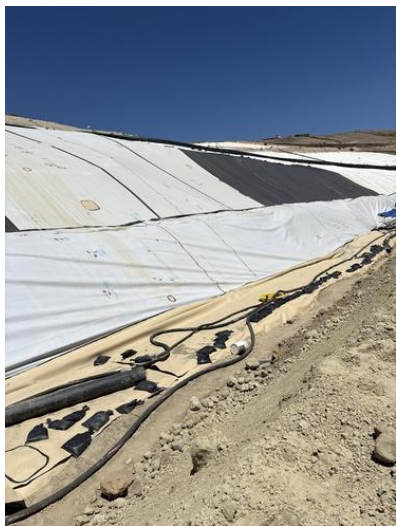


Photo 1

Description of area in photo where there is no leachate seepage or pooling.

Westside perimeter road. None of the seepage previously observed in this area or or 171/172 was observed at the time of this inspection.

4050 - Chiquita Leachate Seep/Pooling Inspection

7 Jul 2026 / Tom Roe

Complete

Conducted on

7 Jul 2026 6:42 AM PDT

Prepared by

Tom Roe

Leachate Seep Inspection

Leachate seep/pooling Inspection

Leachate seep/pooling Inspection 1

Has a leachate seep/pooling been located?

Yes

Which grid is the leachate seep/pooling located?

94

Indicate on the map the location

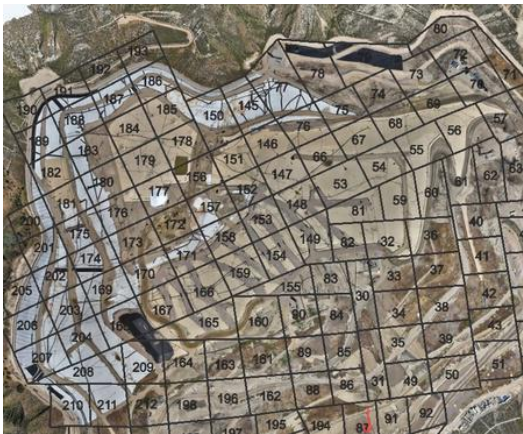


Photo 1

Drop Pin to record lat/long of seep/pooling location.

Castaic CA 91384
United States
(34.43112151863758,
-118.64522615046)

Time seep/pooling was discovered

7 Jul 2026 6:45 AM PDT

Estimated duration of presence of leachate at such location

4 hours

Estimated quantity of leachate

1-5 gallons

Extent of area impacted (approximate sq ft impacted)

20 sq ft

Odor type	Leachate
-----------	----------

Odor intensity	3 - Moderate Odor
----------------	-------------------

Surrounding soil saturation level	Standing free liquid
-----------------------------------	----------------------

Image of seep/pooling



Photo 2

Did the seep/pooling travel into the stormwater channel?	No
--	----

Actions taken to contain seep/pooling?

Soil added and compacted.



Photo 3

4050 - Chiquita Leachate Seep/Pooling Inspection

7 Jul 2026 / Tom Roe

Complete

Conducted on

7 Jul 2026 1:43 PM PDT

Prepared by

Tom Roe

Leachate Seep Inspection

Leachate seep/pooling Inspection

Leachate seep/pooling Inspection 1

Has a leachate seep/pooling been located?

No



Photo 1

Description of area in photo where there is no leachate seepage or pooling.

Westside perimeter road. None of the seepage previously observed in this area, Grid 94 or 171/172 was observed at the time of this inspection.

4050 - Chiquita Leachate Seep/Pooling Inspection

8 Jul 2026 / Tom Roe

Complete

Conducted on

8 Jul 2026 6:48 AM PDT

Prepared by

Tom Roe

Leachate Seep Inspection

Leachate seep/pooling Inspection

Leachate seep/pooling Inspection 1

Has a leachate seep/pooling been located?

No



Photo 1

Description of area in photo where there is no leachate seepage or pooling.

Westside perimeter road. None of the seepage previously observed in this area, Grid 94 or 171/172 was observed at the time of this inspection.

4050 - Chiquita Leachate Seep/Pooling Inspection

8 Jul 2026 / Tom Roe

Complete

Conducted on

8 Jul 2026 2:18 PM PDT

Entire Main Canyon inspected for 27(b)(ii)

Prepared by

Tom Roe

Leachate Seep Inspection

Leachate seep/pooling Inspection

Leachate seep/pooling Inspection 1

Has a leachate seep/pooling been located?

No



Photo 1

Description of area in photo where there is no leachate seepage or pooling.

Westside perimeter road. None of the seepage previously observed in this area, Grid 94 or 171/172 was observed at the time of this inspection.

4050 - Chiquita Leachate Seep/Pooling Inspection

9 Jul 2026 / John Boucher

Complete

Conducted on

9 Jul 2026 7:11 AM PDT

Prepared by

John Boucher

Leachate Seep Inspection

Leachate seep/pooling Inspection

Leachate seep/pooling Inspection 1

Has a leachate seep/pooling been located?

No



Photo 1

Description of area in photo where there is no leachate seepage or pooling.

Westside perimeter road. None of the seepage previously observed in this area or in Grids 171/172 was observed at the time of this inspection

4050 - Chiquita Leachate Seep/Pooling Inspection

9 Jul 2026 / John Boucher

Complete

Conducted on

9 Jul 2026 1:08 PM PDT

Prepared by

John Boucher

Leachate Seep Inspection

Leachate seep/pooling Inspection

Leachate seep/pooling Inspection 1

Has a leachate seep/pooling been located?

No



Photo 1

Description of area in photo where there is no leachate seepage or pooling.

Westside perimeter road. None of the seepage previously observed in this area or in Grids 171/172 was observed at the time of this inspection

4050 - Chiquita Leachate Seep/Pooling Inspection

10 Jul 2026 / John Boucher

Complete

Conducted on

10 Jul 2026 7:11 AM PDT

Prepared by

John Boucher

Leachate Seep Inspection

Leachate seep/pooling Inspection

Leachate seep/pooling Inspection 1

Has a leachate seep/pooling been located?

No



Photo 1

Description of area in photo where there is no leachate seepage or pooling.

Westside perimeter road. None of the seepage previously observed in this area or in Grids 171/172 was observed at the time of this inspection

4050 - Chiquita Leachate Seep/Pooling Inspection

10 Jul 2026 / John Boucher

Complete

Conducted on

10 Jul 2026 2:34 PM PDT

Prepared by

John Boucher

Leachate Seep Inspection

Leachate seep/pooling Inspection

Leachate seep/pooling Inspection 1

Has a leachate seep/pooling been located?

No



Photo 1

Description of area in photo where there is no leachate seepage or pooling.

Westside perimeter road. None of the seepage previously observed in this area or in Grids 171/172 was observed at the time of this inspection

4050 - Chiquita Leachate Seep/Pooling Inspection

11 Jul 2026 / John Boucher

Complete

Conducted on

11 Jul 2026 7:52 AM PDT

Prepared by

John Boucher

Leachate Seep Inspection

Leachate seep/pooling Inspection

Leachate seep/pooling Inspection 1

Has a leachate seep/pooling been located?

No



Photo 1

Description of area in photo where there is no leachate seepage or pooling.

Westside perimeter road. None of the seepage previously observed in this area or in Grids 171/172 was observed at the time of this inspection

4050 - Chiquita Leachate Seep/Pooling Inspection

11 Jul 2026 / John Boucher

Complete

Conducted on

11 Jul 2026 1:05 PM PDT

Prepared by

John Boucher

Leachate Seep Inspection

Leachate seep/pooling Inspection

Leachate seep/pooling Inspection 1

Has a leachate seep/pooling been located?

No



Photo 1

Description of area in photo where there is no leachate seepage or pooling.

Westside perimeter road. None of the seepage previously observed in this area or in Grids 171/172 was observed at the time of this inspection

4050 - Chiquita Leachate Seep/Pooling Inspection

12 Jul 2026 / Tom Roe

Complete

Conducted on

12 Jul 2026 6:41 AM PDT

Prepared by

Tom Roe

Leachate Seep Inspection

Leachate seep/pooling Inspection

Leachate seep/pooling Inspection 1

Has a leachate seep/pooling been located?

No



Photo 1

Description of area in photo where there is no leachate seepage or pooling.

Westside perimeter road. None of the seepage previously observed in this area or in Grids 171/172 was observed at the time of this inspection

4050 - Chiquita Leachate Seep/Pooling Inspection

12 Jul 2026 / Tom Roe

Complete

Conducted on

12 Jul 2026 1:02 PM PDT

Prepared by

Tom Roe

Leachate Seep Inspection

Leachate seep/pooling Inspection

Leachate seep/pooling Inspection 1

Has a leachate seep/pooling been located?

No



Photo 1

Description of area in photo where there is no leachate seepage or pooling.

Westside perimeter road. None of the seepage previously observed in this area or in Grids 171/172 was observed at the time of this inspection