

From: WILLIAM.HALEY@WasteConnections.com
Sent: Friday, July 17, 2026 5:20 PM
To: Karen Gork
Cc: Todd.Thalhamer@Calrecycle.ca.gov; LFrias@ph.lacounty.gov; NQuick@ph.lacounty.gov; RRagland@ph.lacounty.gov; BMcphillips@counsel.lacounty.gov; Wes.Mindermann@CalRecycle.ca.gov; mark.debie@calrecycle.ca.gov; mark.debie@calrecycle.ca.gov; emorofuji@ph.lacounty.gov; btway@ph.lacounty.gov; Relon.MarkAnthony@epa.gov; Holybee.Tyler@epa.gov; Friedli.Laura@epa.gov; John Perkey; Sarah Phillips; Gregory.Shaffer@dtsc.ca.gov; Natasha.DiPietro@dtsc.ca.gov; Gregory.Gentile@dtsc.ca.gov; Dylan Smith
Subject: Chiquita Canyon Landfill – Geosynthetic Cover – Mitigation Measure 4.1
Attachments: RM22.1077-CCL-EVOH-FIG 1-(2026-07-16)-FIG 1.pdf; Milestone 2B Chiquita Canyon LF Isopach_June.2026.pdf; 2026 CCLF Reaction Area_Reactive Wells_2026-06-19.pdf

Below is Chiquita's weekly update on the status of the installation of the 60-mil EVOH/HDPE geomembrane cover at the Chiquita Canyon Landfill, in accordance with Mitigation Measure 4.1 of the LEA's Compliance Order issued May 1, 2025.

As of July 3, 2026, D&E, on behalf of Chiquita, has installed approximately 2,884,621 square feet of tan 60-mil EVOH/HDPE geomembrane cover. Of this total, approximately 678,279 square feet has been deployed on top of the existing 30mil geomembrane to augment its effectiveness. Work conducted the week of July 6 also included repairs and detailing of existing panels, including boot fabrication, patching, extrusion welding, and re-seaming, as needed. Work continued during the week of July 13, 2026.

The attached site map shows the approximate extent of geomembrane cover installed as of Wednesday, July 15, 2026, as well as the geomembrane coverage described in the revised draft workplan for extension of the geomembrane cover area submitted to the LEA, the US EPA, and DTSC on March 13, 2026. Also attached to this submission are the June 2026 monthly isopach map and a figure identifying wells showing signs of reaction as of June 12, 2026 based on the June Reaction Mitigation Area. Due to technical limitations, we are currently unable to create one figure including all of this data.

Thank you,

Dylan Smith

Bill Haley


Sr. Project Engineer

O: 661.257.3655 | C: 661.964.5821


Waste Connections | 29201 Henry Mayo Dr. | Castaic, CA 91384

Connect With the Future © www.wasteconnections.com


P:\SITES\CHIQUITA CYN LF\MONITORING SUMMARY\FIGURES-WEEKLY\RM22.1077-CCL-EVOH-FIG 1--(2026-07-16).DWG July 16, 2026 -- 10:17 AM BY: GLA-USER

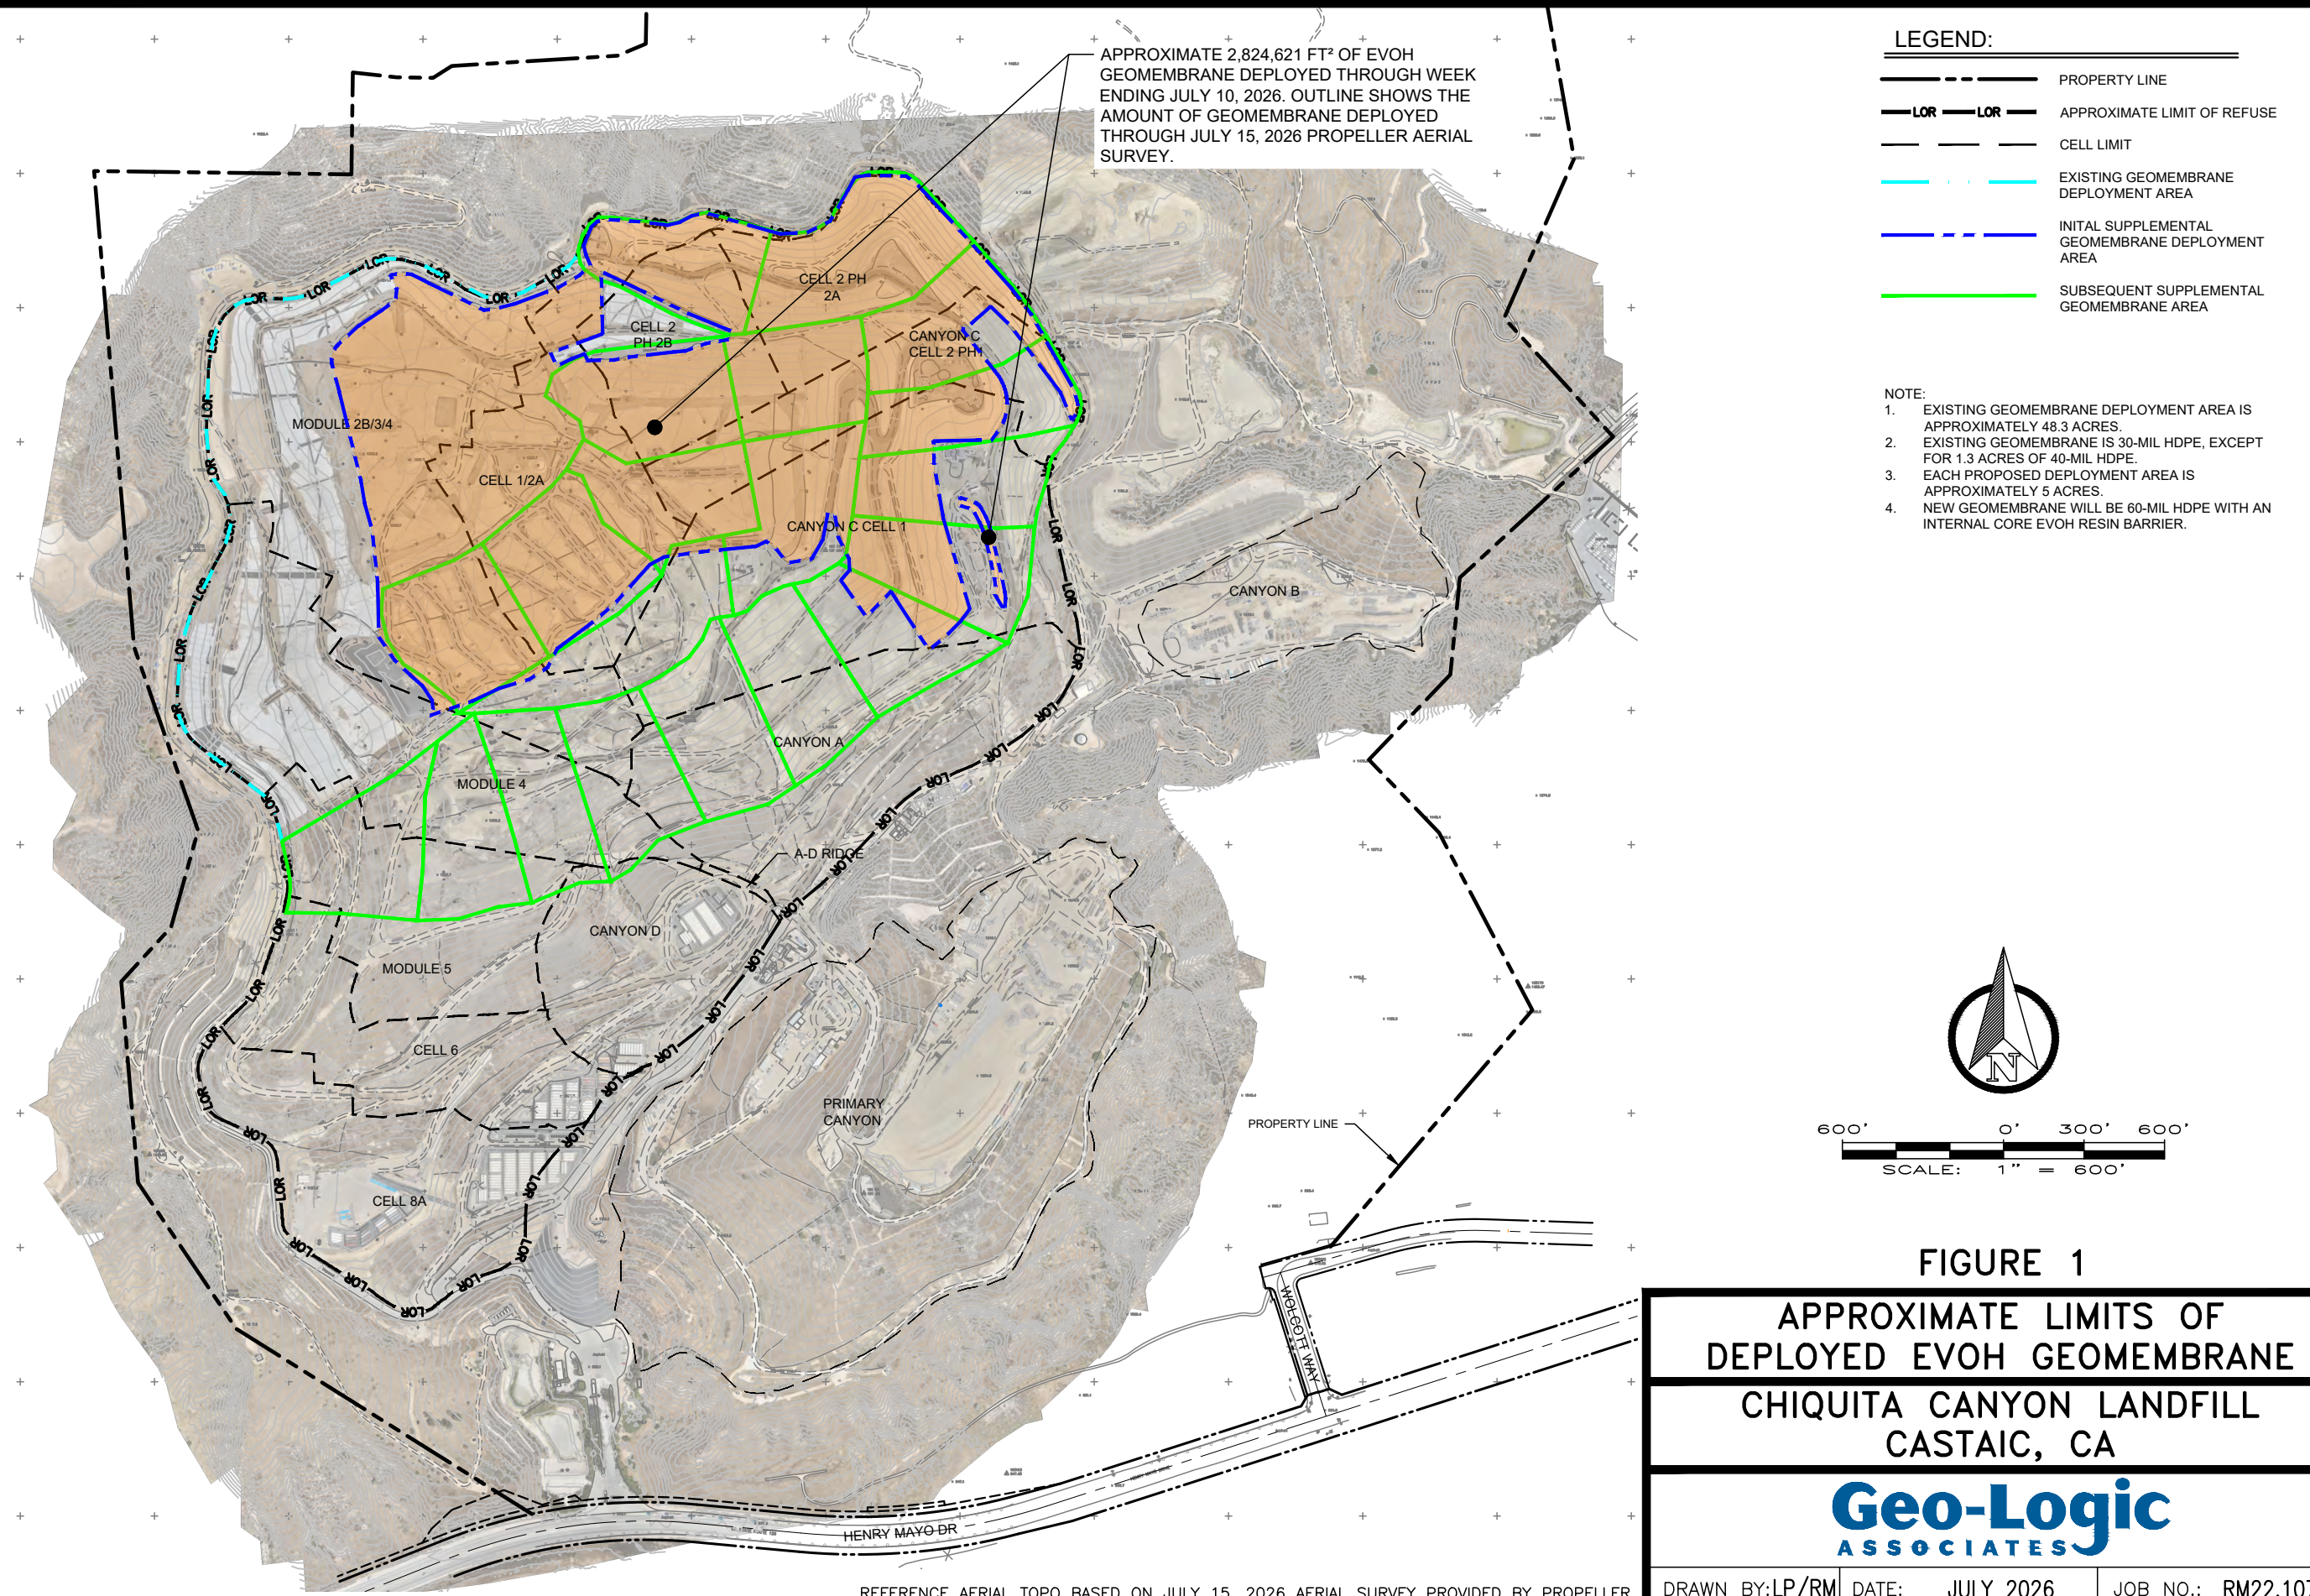

Chiquita Canyon Landfill -Isopach

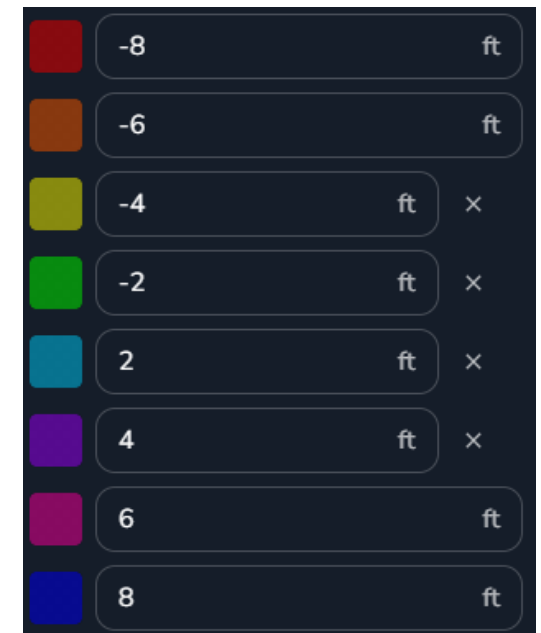

June 24, 2026 Survey Image. June 2, 2026 vs June 24, 2026

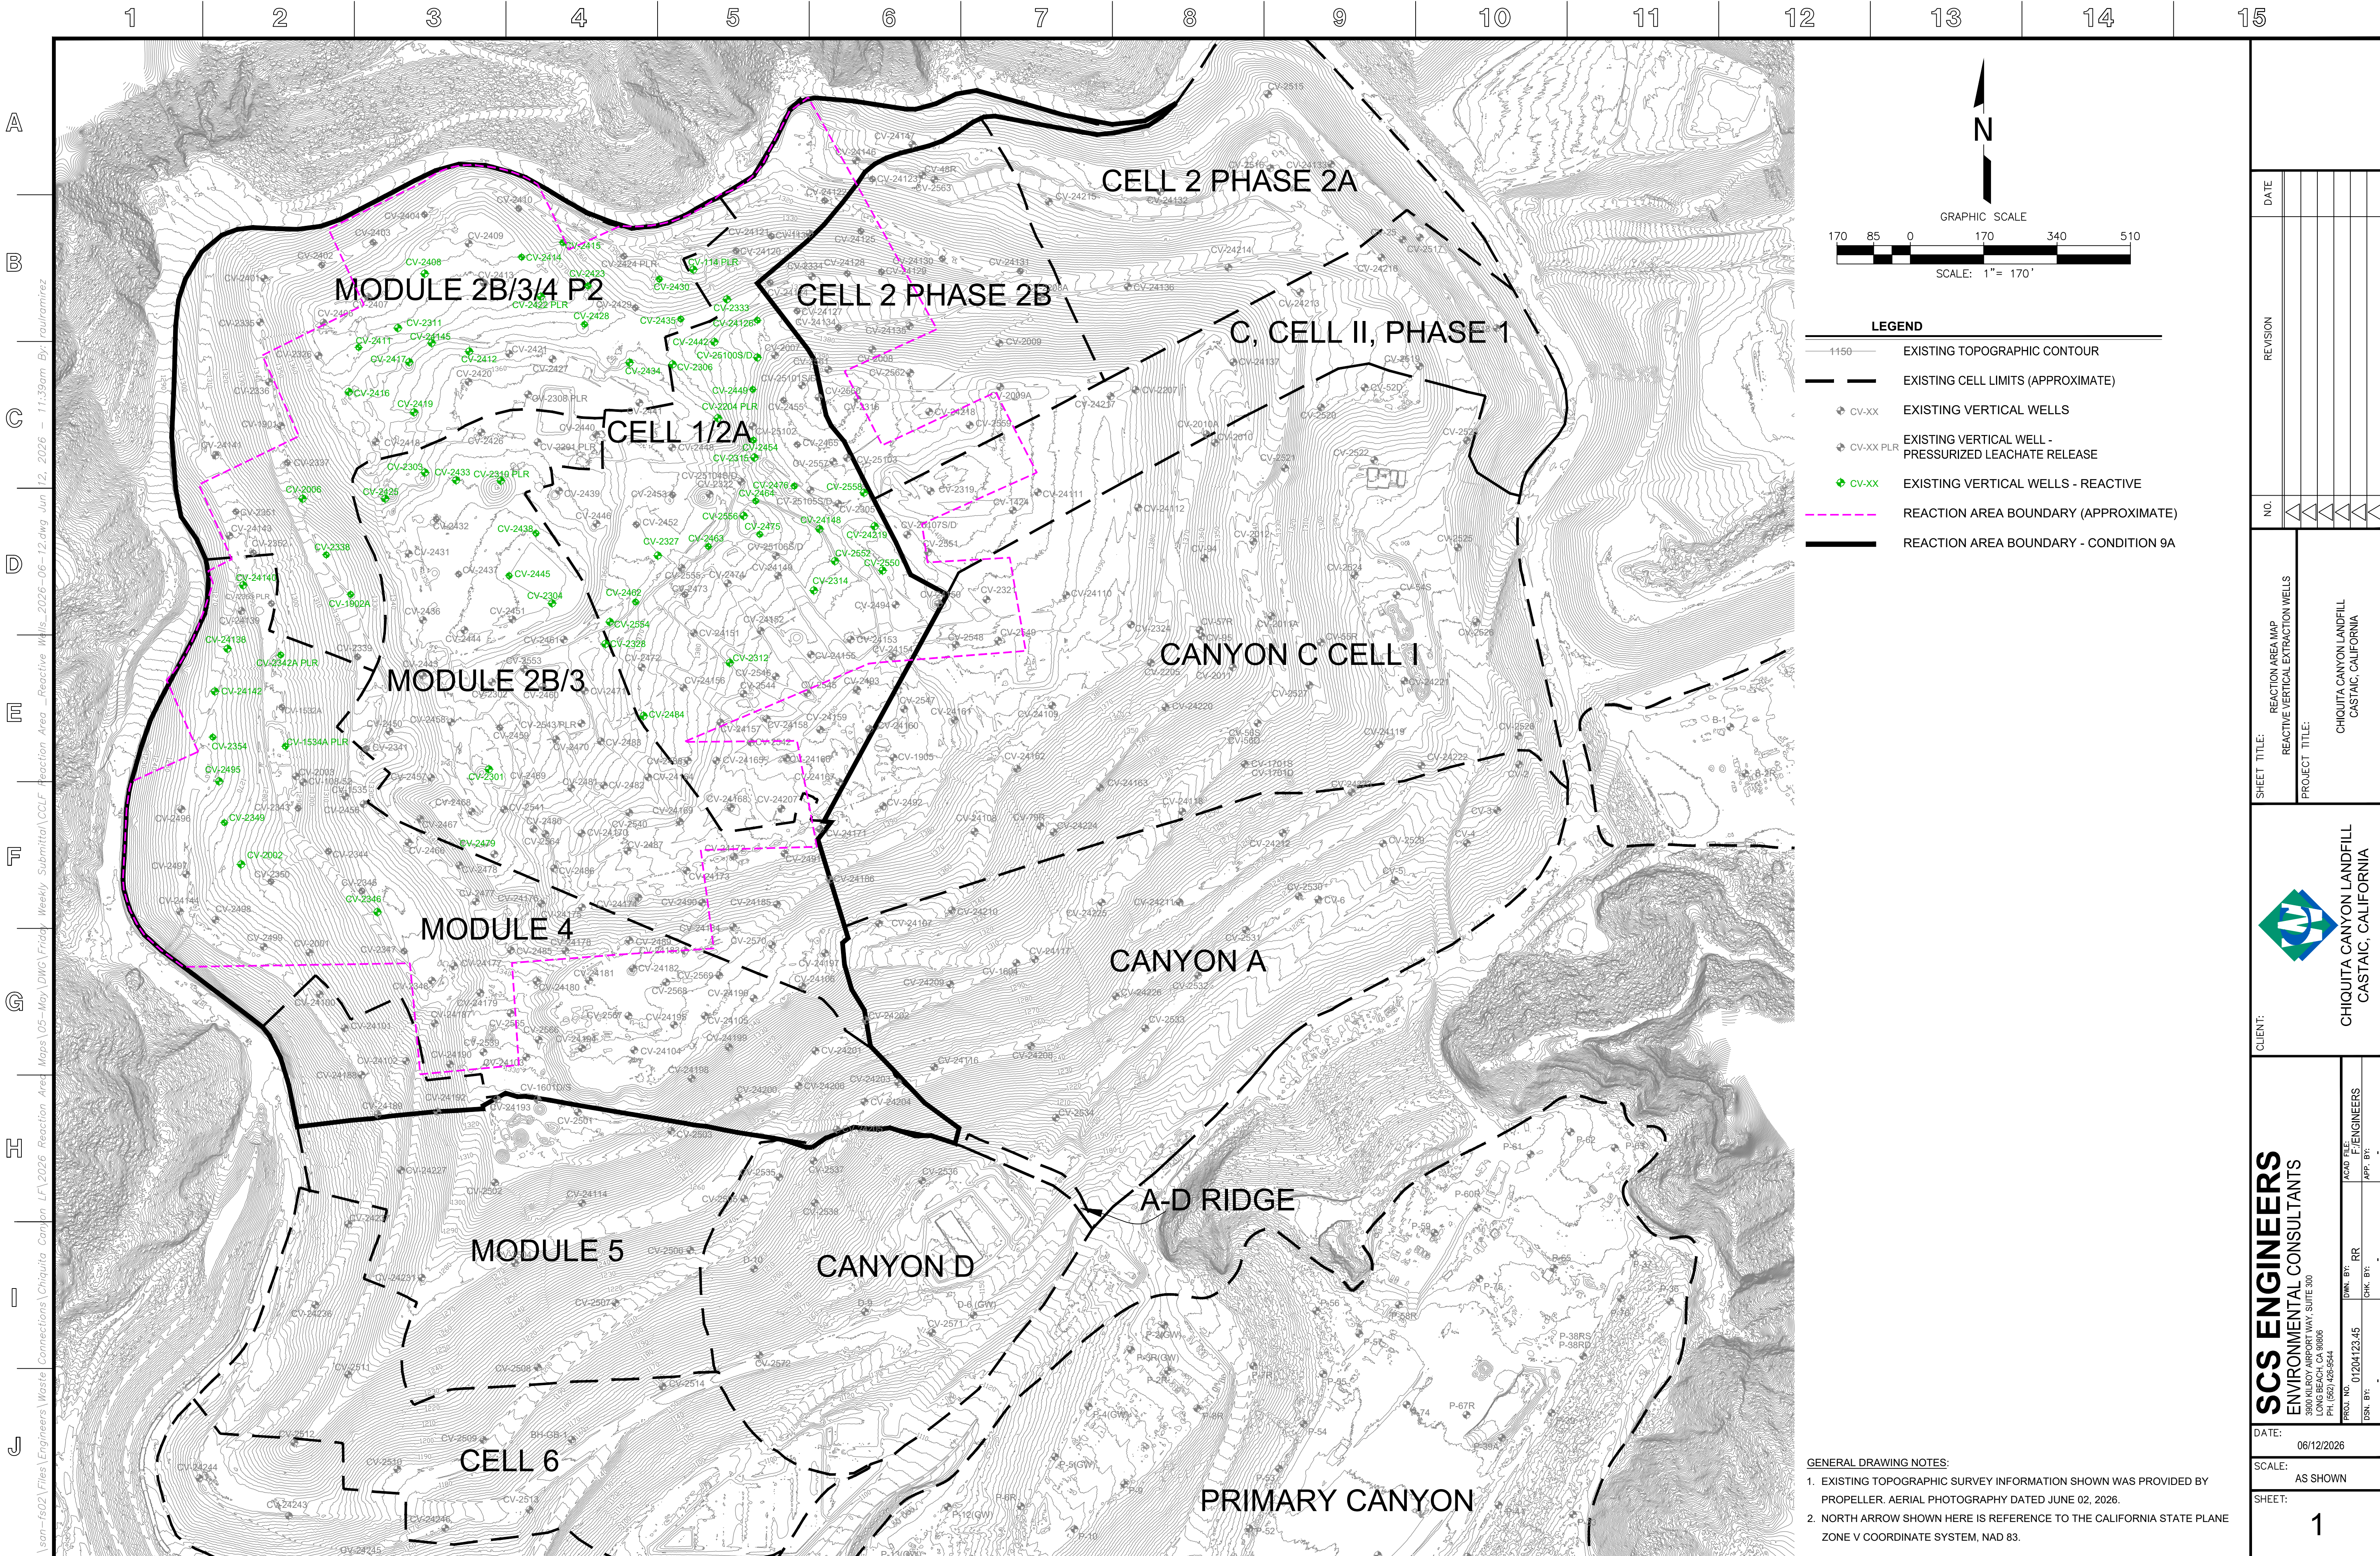

\\san-fs02\Files\Engineers\Waste Connections\Chiquita Canyon LF\2026 Reaction Area Maps\05-May DWG\Friday Weekly Submittal\CCLF Reaction Area - Reactive Wells 2026-06-12.dwg Jun 12, 2026 - 11:39am By:raulramirez

CLIENT:	CHIQUITA CANYON LANDFILL CASTAIC, CALIFORNIA	
	CHIQUITA CANYON LANDFILL CASTAIC, CALIFORNIA	
SHEET TITLE:	REACTION AREA MAP REACTIVE VERTICAL EXTRACTION WELLS	
	PROJECT TITLE:	
DATE:	06/12/2026	
SCALE:	AS SHOWN	
SHEET:	1	

NO.	1	2	3	4	5	6	7	8	9	10	11	12	13	14	15
REVISION															
DATE															

PROJ. NO.	01204123-45	DWN. BY:	RR	APP. BY:	
DATE	06/12/2026	CHECKED BY:		DATE	

SCS ENGINEERS
ENVIRONMENTAL CONSULTANTS
LONG BEACH, CA 90806
PH: (562) 426-9544

ACADE FILE:
F:\ENGINEERS