
De: Medina, Steven <SMedina@scsengineers.com>
Enviado: Viernes 17 de mayo de 2024 a las 4:18 PM
Para: bchen@aqmd.gov; ndickel@aqmd.gov; Christina Ojeda
Cc: Steve Cassulo; Haley, William (Bill); amanda.froman; Michael Hearn; Nicole Ward; Christopher.Fear@WasteConnections.com; Viswanathan, Srividhya; Kelly Kincella; Han, Jessie
Asunto: Asunto: Orden de Depuración Estipulada del Caso No. 6177-4 - Actualización sobre la Instalación y Operación Semanal de las Bombas
Adjuntos: 2024 CCLF Existing De-Watering Well with Pump Map_2024-05-17.pdf

[REMITENTE EXTERNO: Tenga precaución con los enlaces/adjuntos]

Todos,

Según la Condición 65 de la Orden Estipulada Modificada, a continuación se encuentra el resumen de la instalación y operación de las bombas de desagüe para el Vertedero de Chiquita Canyon.

Durante el período que transcurrió desde el 10/05/2024 hasta el 16/05/2024, Chiquita completó la instalación y comenzó a operar durante el día cinco (5) bombas en pozos verticales de extracción de LFG dando un total de cincuenta y una (51) bombas operando en pozos verticales de extracción de LFG. Por favor, consulte el Mapa actualizado de pozos de LFG con bombas operando, adjunto.

Durante el período que va del 17/05/2024 hasta el 23/05/2024, Chiquita tiene planeado instalar y comenzar a operar otras ocho (8) bombas en pozos verticales de extracción de LFG en ubicaciones a lo largo de la pendiente occidental y la cubierta superior del área de reacción. Las ubicaciones de las instalaciones de las bombas para la semana que viene están sujetas a cambios debido a las condiciones climáticas y/o de seguridad.

Gracias,

Steven Ruben Medina, **E.I.T.**

Profesional Asociado

SCS Engineers

3900 Kilroy Airport Way, Suite 100

Long Beach, CA 90806

858-204-4342 (c)


5160srm@scsengineers.com

Dirigidos por el Éxito de los Clientes

www.scsengineers.com

*2024 Conrad Quality Focus
Award Recipient*



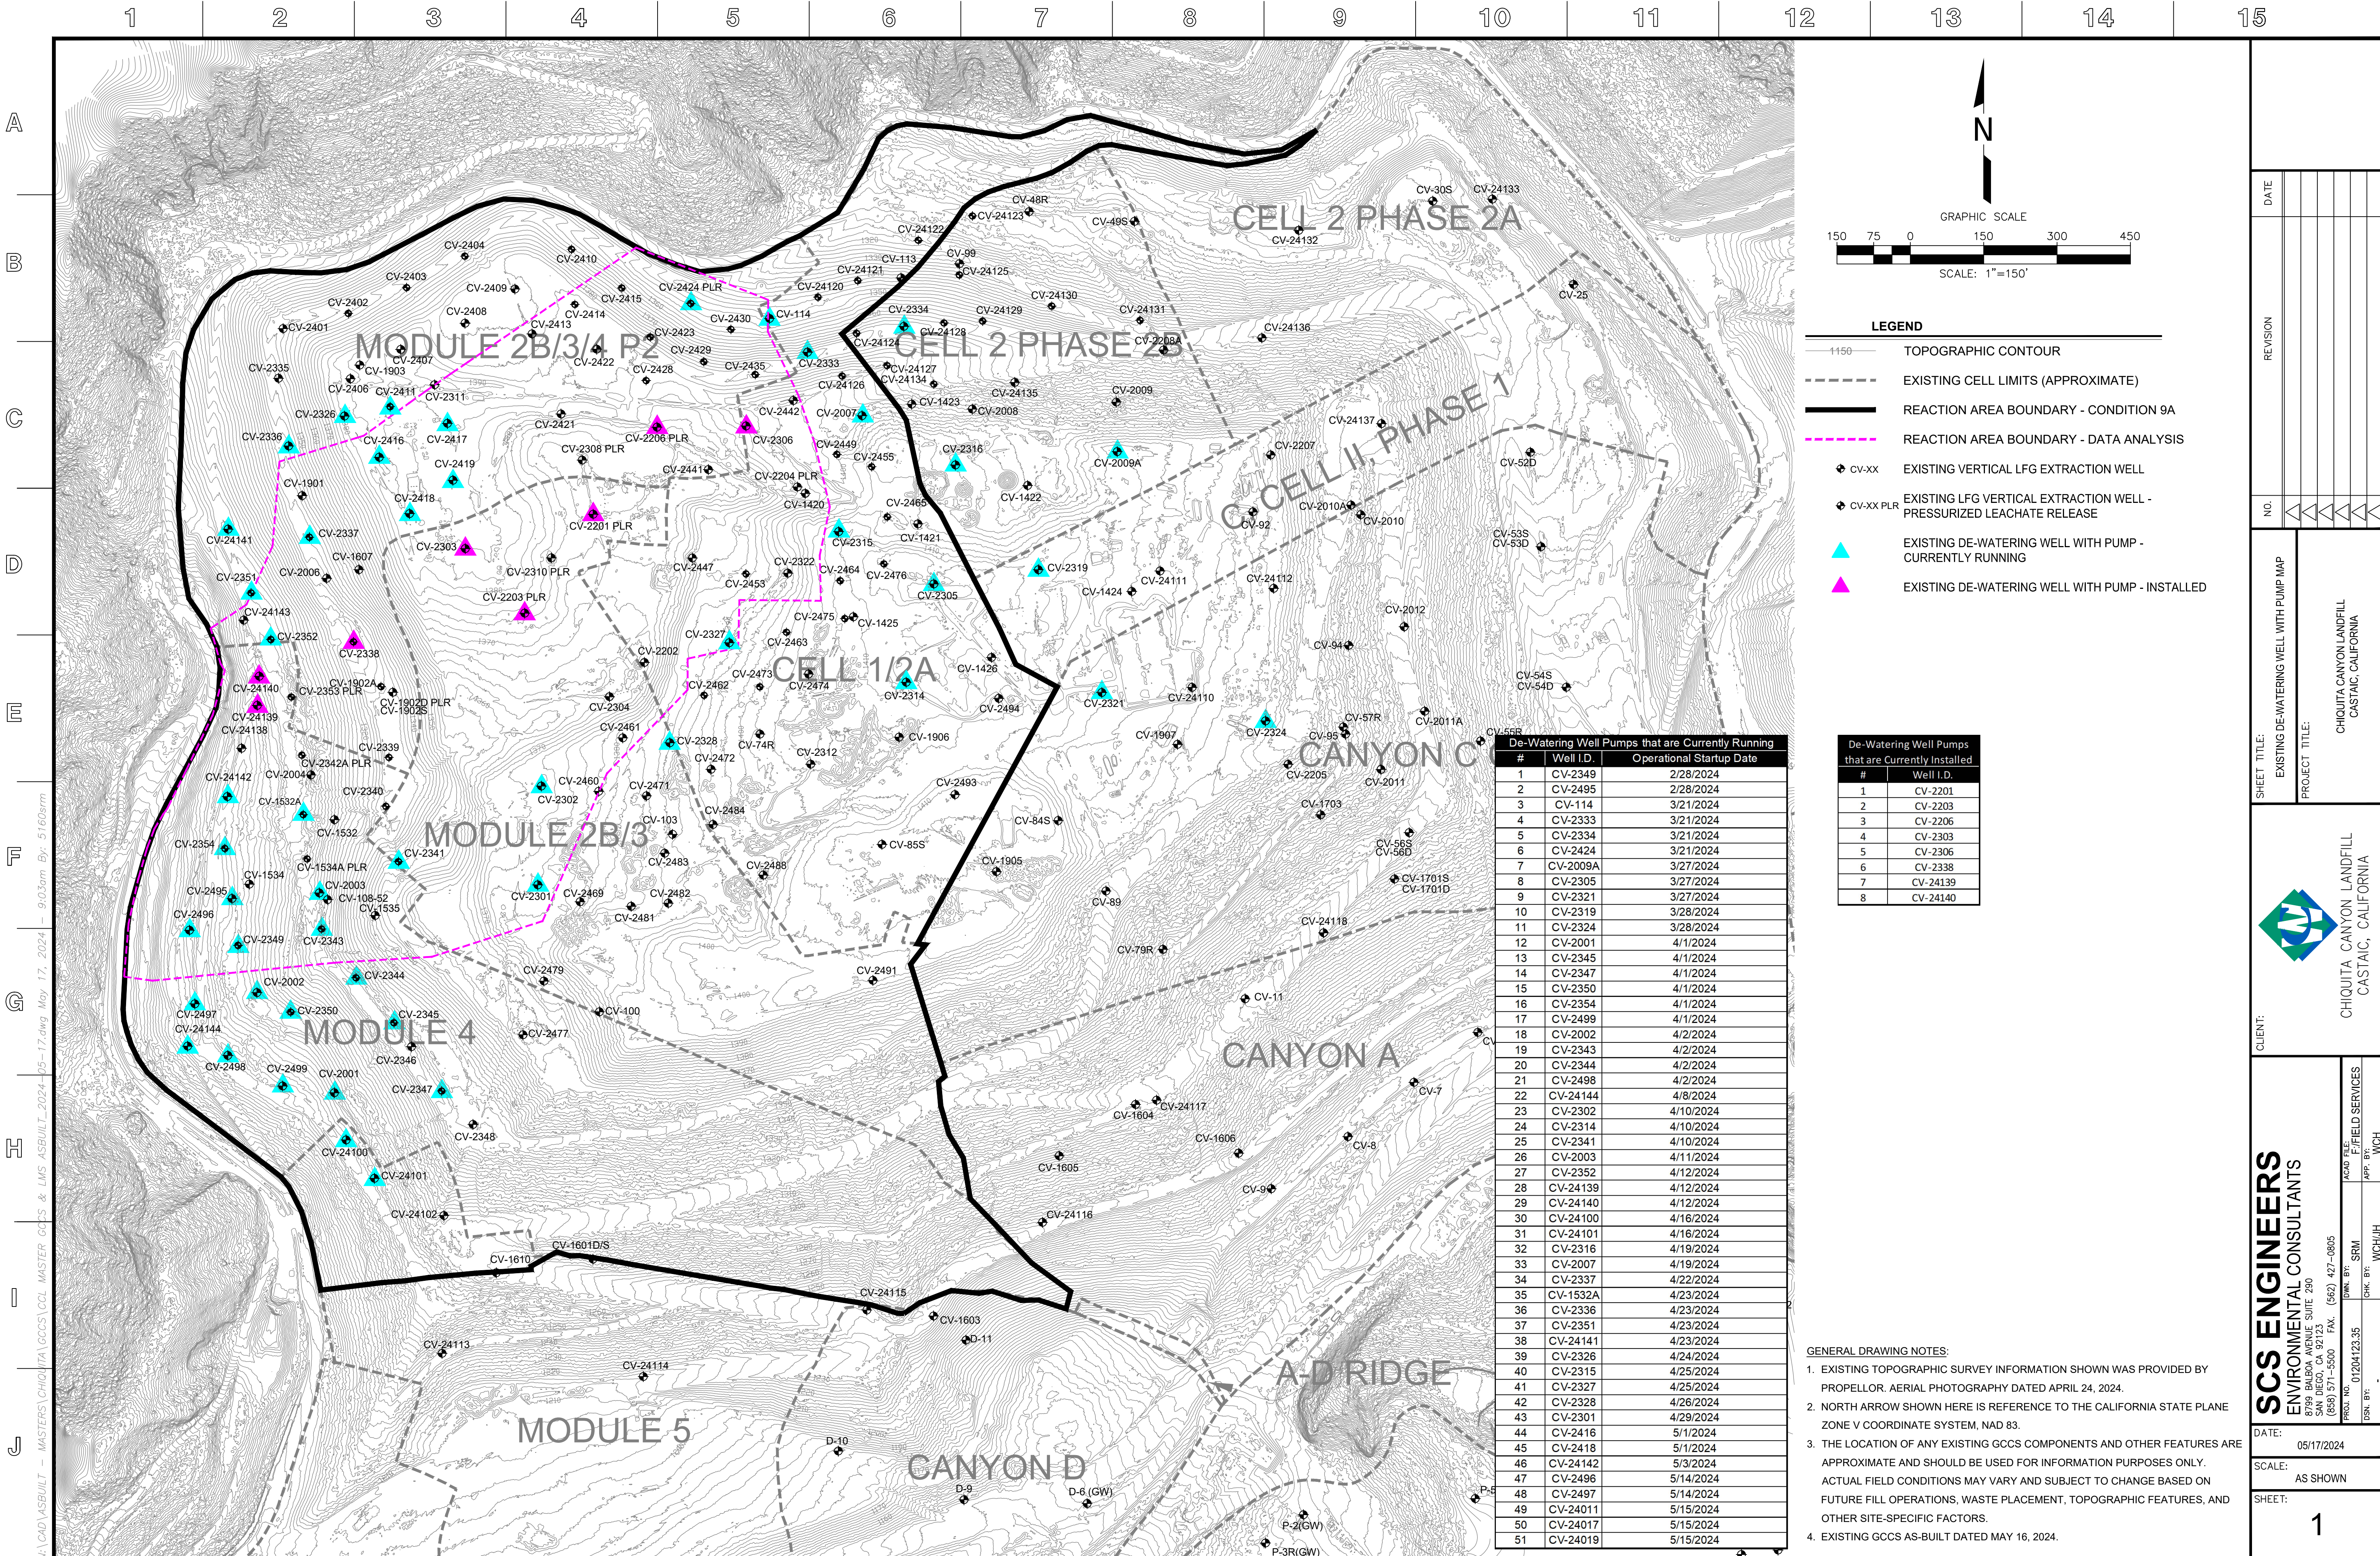

N

GRAPHIC SCALE
150 75 0 150 300 450
SCALE: 1"=150'

LEGEND

1150

TOPOGRAPHIC CONTOUR

EXISTING CELL LIMITS (APPROXIMATE)

REACTION AREA BOUNDARY - CONDITION 9A

REACTION AREA BOUNDARY - DATA ANALYSIS

CV-XX

EXISTING VERTICAL LFG EXTRACTION WELL

CV-XX PLR

EXISTING LFG VERTICAL EXTRACTION WELL - PRESSURIZED LEACHATE RELEASE

▲

EXISTING DE-WATERING WELL WITH PUMP - CURRENTLY RUNNING

▲

EXISTING DE-WATERING WELL WITH PUMP - INSTALLED

De-Watering Well Pumps that are Currently Running		
#	Well I.D.	Operational Startup Date
1	CV-2349	2/28/2024
2	CV-2495	2/28/2024
3	CV-114	3/21/2024
4	CV-2333	3/21/2024
5	CV-2334	3/21/2024
6	CV-2424	3/21/2024
7	CV-2009A	3/27/2024
8	CV-2305	3/27/2024
9	CV-2321	3/27/2024
10	CV-2319	3/28/2024
11	CV-2324	3/28/2024
12	CV-2001	4/1/2024
13	CV-2345	4/1/2024
14	CV-2347	4/1/2024
15	CV-2350	4/1/2024
16	CV-2354	4/1/2024
17	CV-2499	4/1/2024
18	CV-2002	4/2/2024
19	CV-2343	4/2/2024
20	CV-2344	4/2/2024
21	CV-2498	4/2/2024
22	CV-24144	4/8/2024
23	CV-2302	4/10/2024
24	CV-2314	4/10/2024
25	CV-2341	4/10/2024
26	CV-2003	4/11/2024
27	CV-2352	4/12/2024
28	CV-24139	4/12/2024
29	CV-24140	4/12/2024
30	CV-24100	4/16/2024
31	CV-24101	4/16/2024
32	CV-2316	4/19/2024
33	CV-2007	4/19/2024
34	CV-2337	4/22/2024
35	CV-1532A	4/23/2024
36	CV-2336	4/23/2024
37	CV-2351	4/23/2024
38	CV-24141	4/23/2024
39	CV-2326	4/24/2024
40	CV-2315	4/25/2024
41	CV-2327	4/25/2024
42	CV-2328	4/26/2024
43	CV-2301	4/29/2024
44	CV-2416	5/1/2024
45	CV-2418	5/1/2024
46	CV-24142	5/3/2024
47	CV-2496	5/14/2024
48	CV-2497	5/14/2024
49	CV-24011	5/15/2024
50	CV-24017	5/15/2024
51	CV-24019	5/15/2024

De-Watering Well Pumps that are Currently Installed	
#	Well I.D.
1	CV-2201
2	CV-2203
3	CV-2206
4	CV-2303
5	CV-2306
6	CV-2338
7	CV-24139
8	CV-24140

- GENERAL DRAWING NOTES:
- EXISTING TOPOGRAPHIC SURVEY INFORMATION SHOWN WAS PROVIDED BY PROPELLOR. AERIAL PHOTOGRAPHY DATED APRIL 24, 2024.
 - NORTH ARROW SHOWN HERE IS REFERENCE TO THE CALIFORNIA STATE PLANE ZONE V COORDINATE SYSTEM, NAD 83.
 - THE LOCATION OF ANY EXISTING GCCS COMPONENTS AND OTHER FEATURES ARE APPROXIMATE AND SHOULD BE USED FOR INFORMATION PURPOSES ONLY. ACTUAL FIELD CONDITIONS MAY VARY AND SUBJECT TO CHANGE BASED ON FUTURE FILL OPERATIONS, WASTE PLACEMENT, TOPOGRAPHIC FEATURES, AND OTHER SITE-SPECIFIC FACTORS.
 - EXISTING GCCS AS-BUILT DATED MAY 16, 2024.

DATE

REVISION

NO.

SHEET TITLE:

EXISTING DE-WATERING WELL WITH PUMP MAP

PROJECT TITLE:

CHIQUITA CANYON LANDFILL
CASTAIC, CALIFORNIA

CLIENT:

CHIQUITA CANYON LANDFILL
CASTAIC, CALIFORNIA

SCS ENGINEERS

ENVIRONMENTAL CONSULTANTS


PROJ. NO. 01204123.35
DWN. BY: SRM
CHK. BY: WCH/JH

DATE:

05/17/2024

SCALE:

AS SHOWN

SHEET:

1