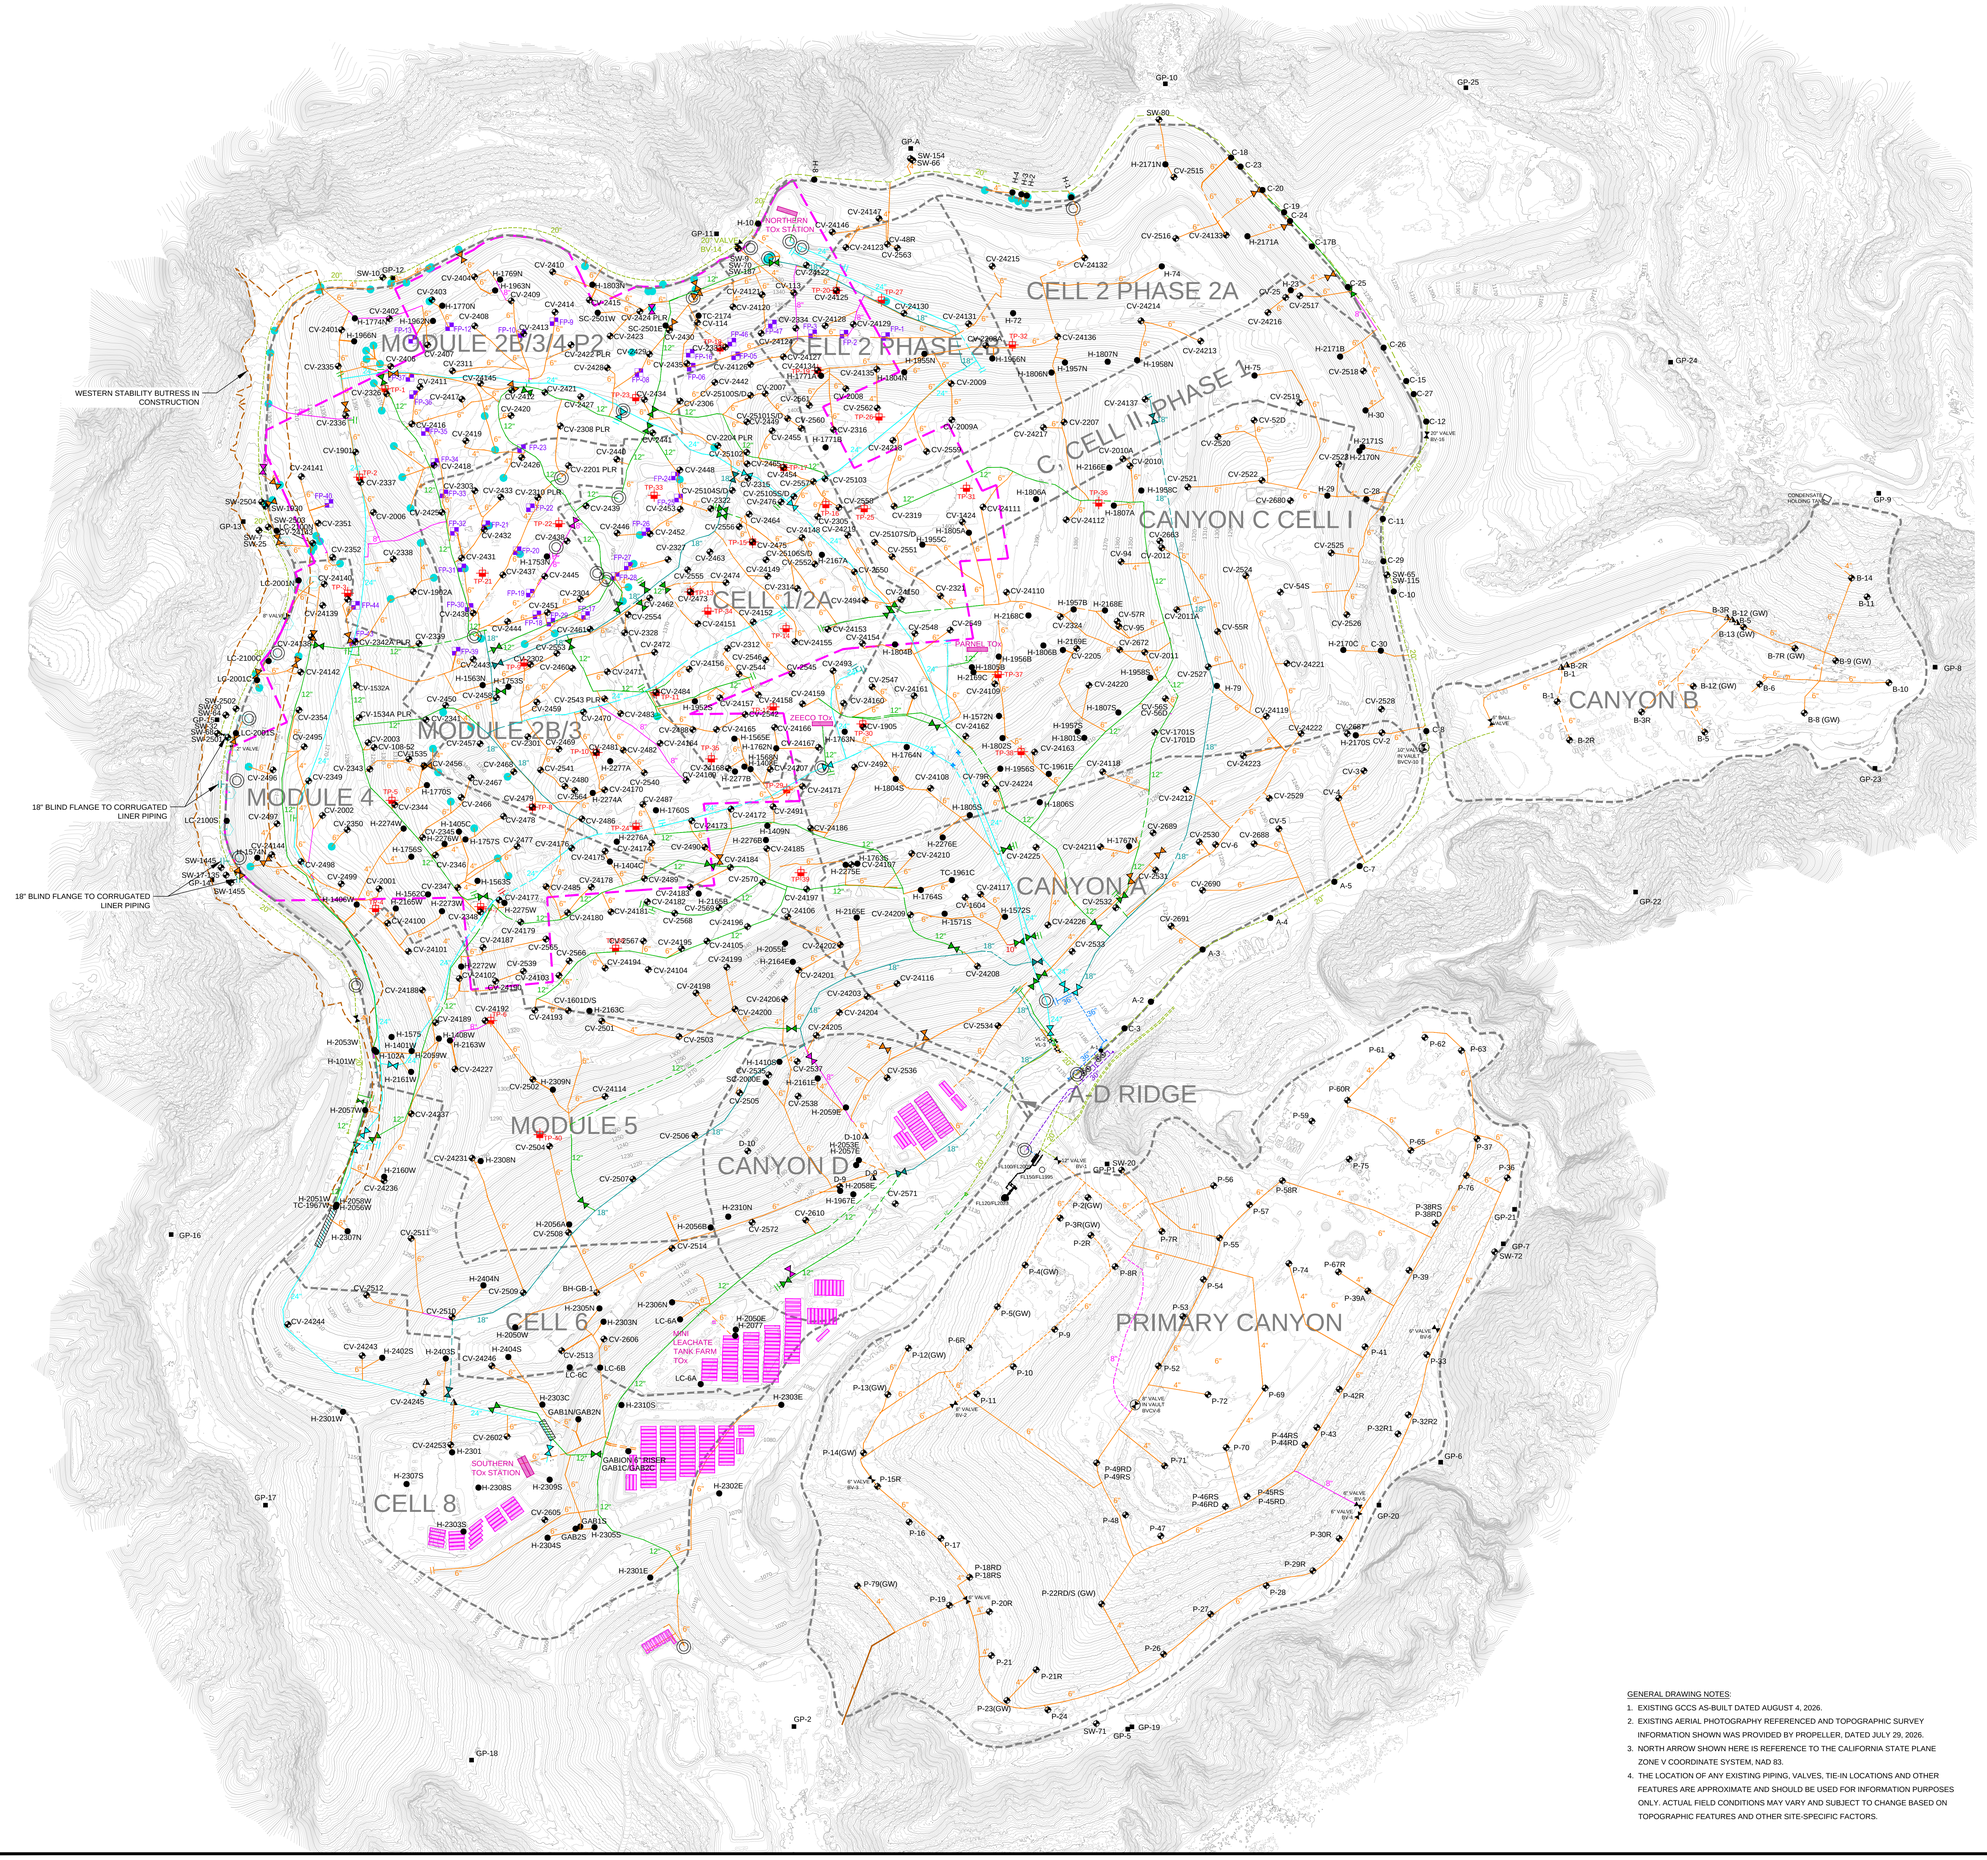

LEGEND

1150	TOPOGRAPHIC CONTOUR
	REACTION MITIGATION AREA BOUNDARY
	WESTERN BUTRESS FILL LIMITS
	EXISTING CELL LIMITS (APPROXIMATE)
36"	EXISTING 36" LFG COLLECTION HEADER PIPING
30"	EXISTING 30" LFG COLLECTION HEADER PIPING
24"	EXISTING 24" LFG COLLECTION HEADER PIPING
20"	EXISTING 20" LFG COLLECTION HEADER PIPING
18"	EXISTING 18" LFG COLLECTION HEADER PIPING
12"	EXISTING 12" LFG COLLECTION HEADER PIPING
10"	EXISTING 10" LFG COLLECTION HEADER PIPING
8"	EXISTING 8" LFG COLLECTION LATERAL PIPING
4"/6"	EXISTING 4"/6" LFG COLLECTION LATERAL PIPING
	BELOW-GRADE PIPES ARE SHOWN DASHED
	EXISTING FRAC TANKS
	EXISTING ACTIVATED CARBON VESSEL
	EXISTING CONDENSATE SUMP
	EXISTING CORRUGATED LINER RISER
	EXISTING HDPE LINER RISER
CV/B/D/P-XX	EXISTING LFG VERTICAL EXTRACTION WELL - MAIN CANYON, CANYON A, B, D, PRIMARY
CV-XX PLR	EXISTING LFG VERTICAL EXTRACTION WELL - PRESSURIZED LEACHATE RELEASE
BH-GB	EXISTING GABION LFG COLLECTOR WELL
SW-XX	EXISTING SOIL VAPOR EXTRACTION WELL
FP-XX	EXISTING SURFACE COLLECTOR WELLHEAD
H/TC/SC-XX	EXISTING HORIZONTAL, TRENCH, SLOPE, COLLECTOR WELL
GP-XX	EXISTING REMOTE VERTICAL WELLHEAD
C-XX	EXISTING PERIMETER MIGRATION PROBE
TP-XX	EXISTING TEMPERATURE PROBE
	EXISTING ISOLATION VALVE
	EXISTING BLIND FLANGE

GENERAL DRAWING NOTES:

1. EXISTING GCCS AS-BUILT DATED AUGUST 4, 2026.
2. EXISTING AERIAL PHOTOGRAPHY REFERENCED AND TOPOGRAPHIC SURVEY INFORMATION SHOWN WAS PROVIDED BY PROPELLER, DATED JULY 29, 2026.
3. NORTH ARROW SHOWN HERE IS REFERENCE TO THE CALIFORNIA STATE PLANE ZONE V COORDINATE SYSTEM, NAD 83.
4. THE LOCATION OF ANY EXISTING PIPING, VALVES, TIE-IN LOCATIONS AND OTHER FEATURES ARE APPROXIMATE AND SHOULD BE USED FOR INFORMATION PURPOSES ONLY. ACTUAL FIELD CONDITIONS MAY VARY AND SUBJECT TO CHANGE BASED ON TOPOGRAPHIC FEATURES AND OTHER SITE-SPECIFIC FACTORS.

NO.	REVISION	DATE

SHEET TITLE: EXISTING GCCS MAP

PROJECT TITLE: CHIQUITA CANYON LANDFILL CASTAIC, CALIFORNIA

CLIENT: CHIQUITA CANYON LANDFILL CASTAIC, CALIFORNIA

SCS ENGINEERS
ENVIRONMENTAL CONSULTANTS
3900 KILROY AIRPORT WAY, SUITE 300
LONG BEACH, CA 90806
PH. (562) 426-9544

PROJ. NO. 01204123.45	DWN. BY: RR / CNW	ACCT. NO. 5-42-42-5810-LT-44-5TERS	
		APP. BY: -	
DSN. BY: SRM / RNH	CHK. BY: RNH		

DATE: 08/03/2026

SCALE: AS SHOWN

\\san-fs02\Data\Files\Engineers\Waste Connections\Chiquita Canyon LF\2026 LEA Correspondence\CCLF Weekly LEA Maps\2026-08-04 CCLF LEA Report Figure - working.dwg Aug 04, 2026 - 5:51pm By: lallen