

From: WILLIAM.HALEY@WasteConnections.com
Sent: Friday, August 7, 2026 10:20 PM
To: Karen Gork
Cc: Todd.Thalhamer@Calrecycle.ca.gov; LFrias@ph.lacounty.gov; NQuick@ph.lacounty.gov; RRagland@ph.lacounty.gov; BMcphillips@counsel.lacounty.gov; Wes.Mindermann@CalRecycle.ca.gov; mark.debie@calrecycle.ca.gov; mark.debie@calrecycle.ca.gov; emorofuji@ph.lacounty.gov; btway@ph.lacounty.gov; Relon.MarkAnthony@epa.gov; Holybee.Tyler@epa.gov; Friedli.Laura@epa.gov; John Perkey; Sarah Phillips; Gregory.Shaffer@dtsc.ca.gov; Natasha.DiPietro@dtsc.ca.gov; Gregory.Gentile@dtsc.ca.gov; Dylan Smith
Subject: Re: Chiquita Canyon Landfill – Geosynthetic Cover – Mitigation Measure 4.1
Attachments: CCLF Reaction Area _Reactive Wells_2026-07-20.pdf; RM22.1077-CCL-EVOH-FIG 1-(2026-08-03)-FIG 1.pdf; Milestone 2B Chiquita Canyon LF Isopach_Jul.2026.pdf

Below is Chiquita's weekly update on the status of the installation of the 60-mil EVOH/HDPE geomembrane cover at the Chiquita Canyon Landfill, in accordance with Mitigation Measure 4.1 of the LEA's Compliance Order issued May 1, 2025.

As of July 31, 2026, D&E, on behalf of Chiquita, has installed approximately 3,174,427 square feet of tan 60-mil EVOH/HDPE geomembrane cover. Of this total, approximately 736,689 square feet has been deployed on top of the existing 30mil geomembrane to augment its effectiveness. Work conducted the week of July 27 also included repairs and detailing of existing panels, including boot fabrication, patching, extrusion welding, and re-seaming, as needed. Work continued during the week of August 3, 2026.

The attached site map shows the approximate extent of geomembrane cover installed as of Wednesday, July 29, 2026, as well as the geomembrane coverage described in the revised draft workplan for extension of the geomembrane cover area submitted to the LEA, the US EPA, and DTSC on March 13, 2026. Also attached to this submission are the July 2026 monthly isopach map and a figure identifying wells showing signs of reaction as of July 20, 2026 based on the June Reaction Mitigation Area. Due to technical limitations, we are currently unable to create one figure including all of this data.

Thank you,


Bill Haley

Sr. Project Engineer


O: 661.257.3655 | C: 661.964.5821

Waste Connections | 29201 Henry Mayo Dr. | Castaic, CA 91384


Connect With the Future © www.wasteconnections.com

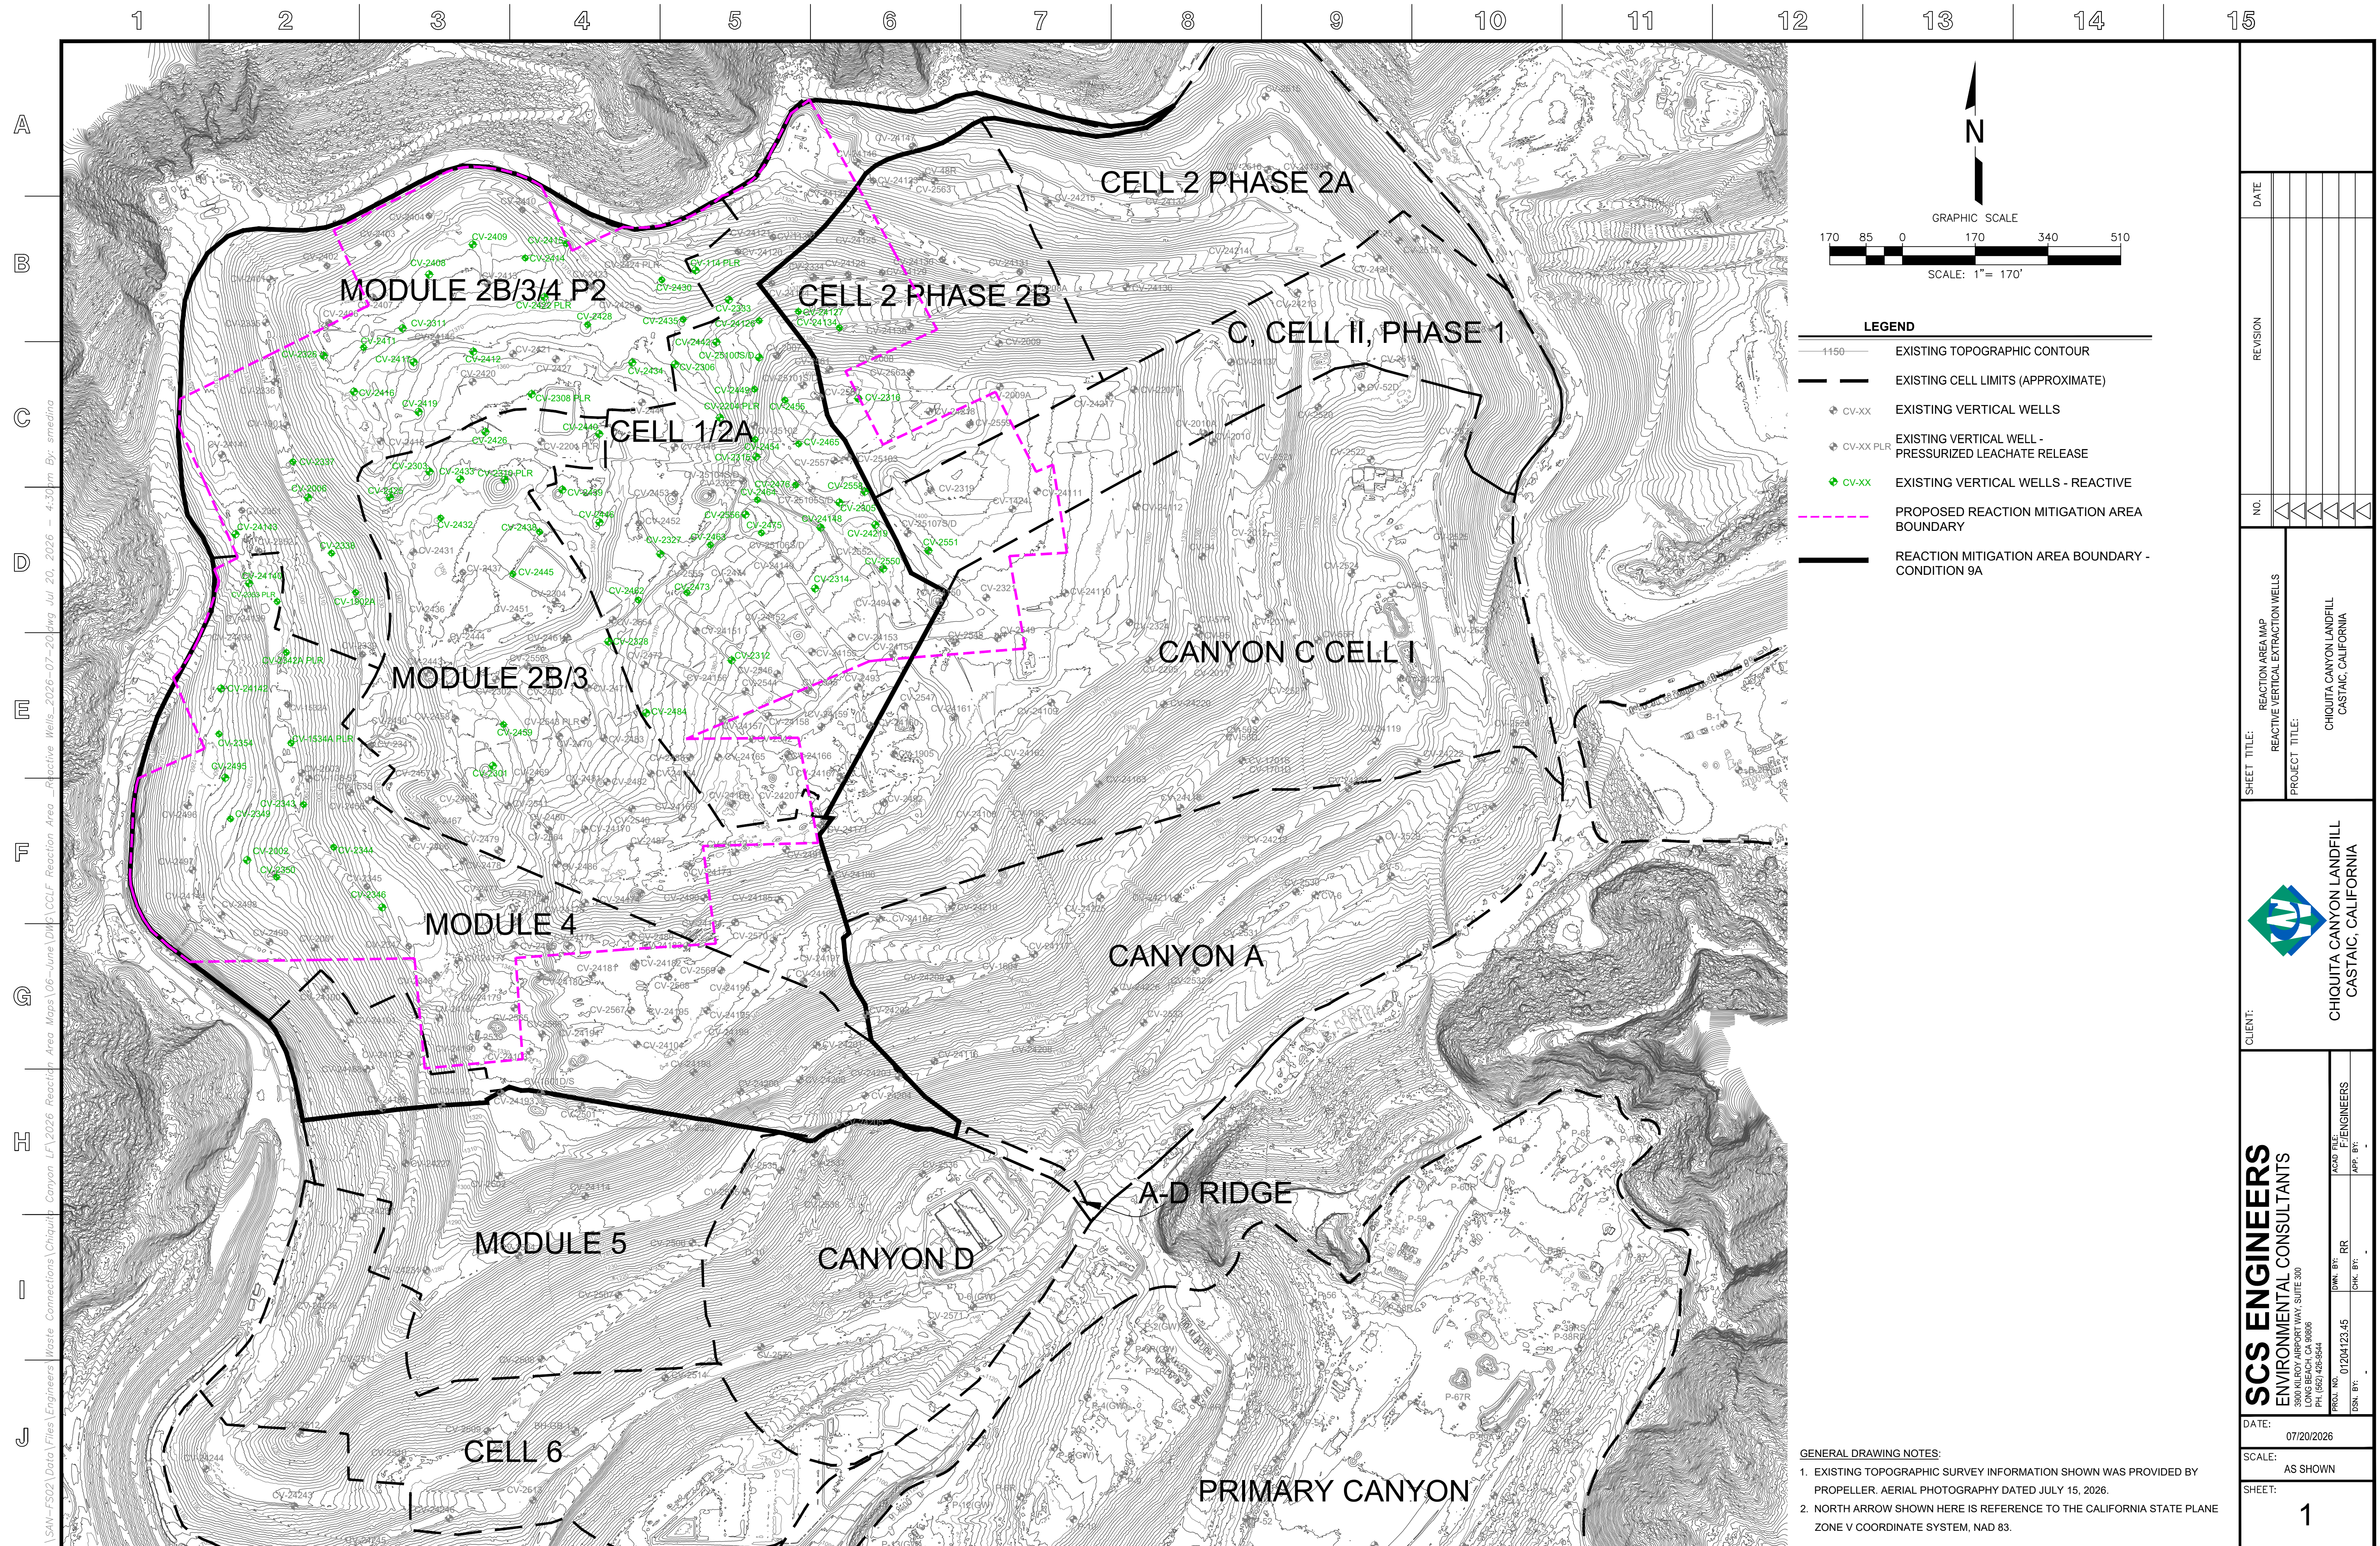

P:\SITES\CHIQUITA CYN LF\MONITORING SUMMARY\FIGURES-WEEKLY\RM22.1077-CCL-EVOH-FIG 1-(2026-08-03).DWG August 3, 2026 - 3:49 PM BY: GLA-USER

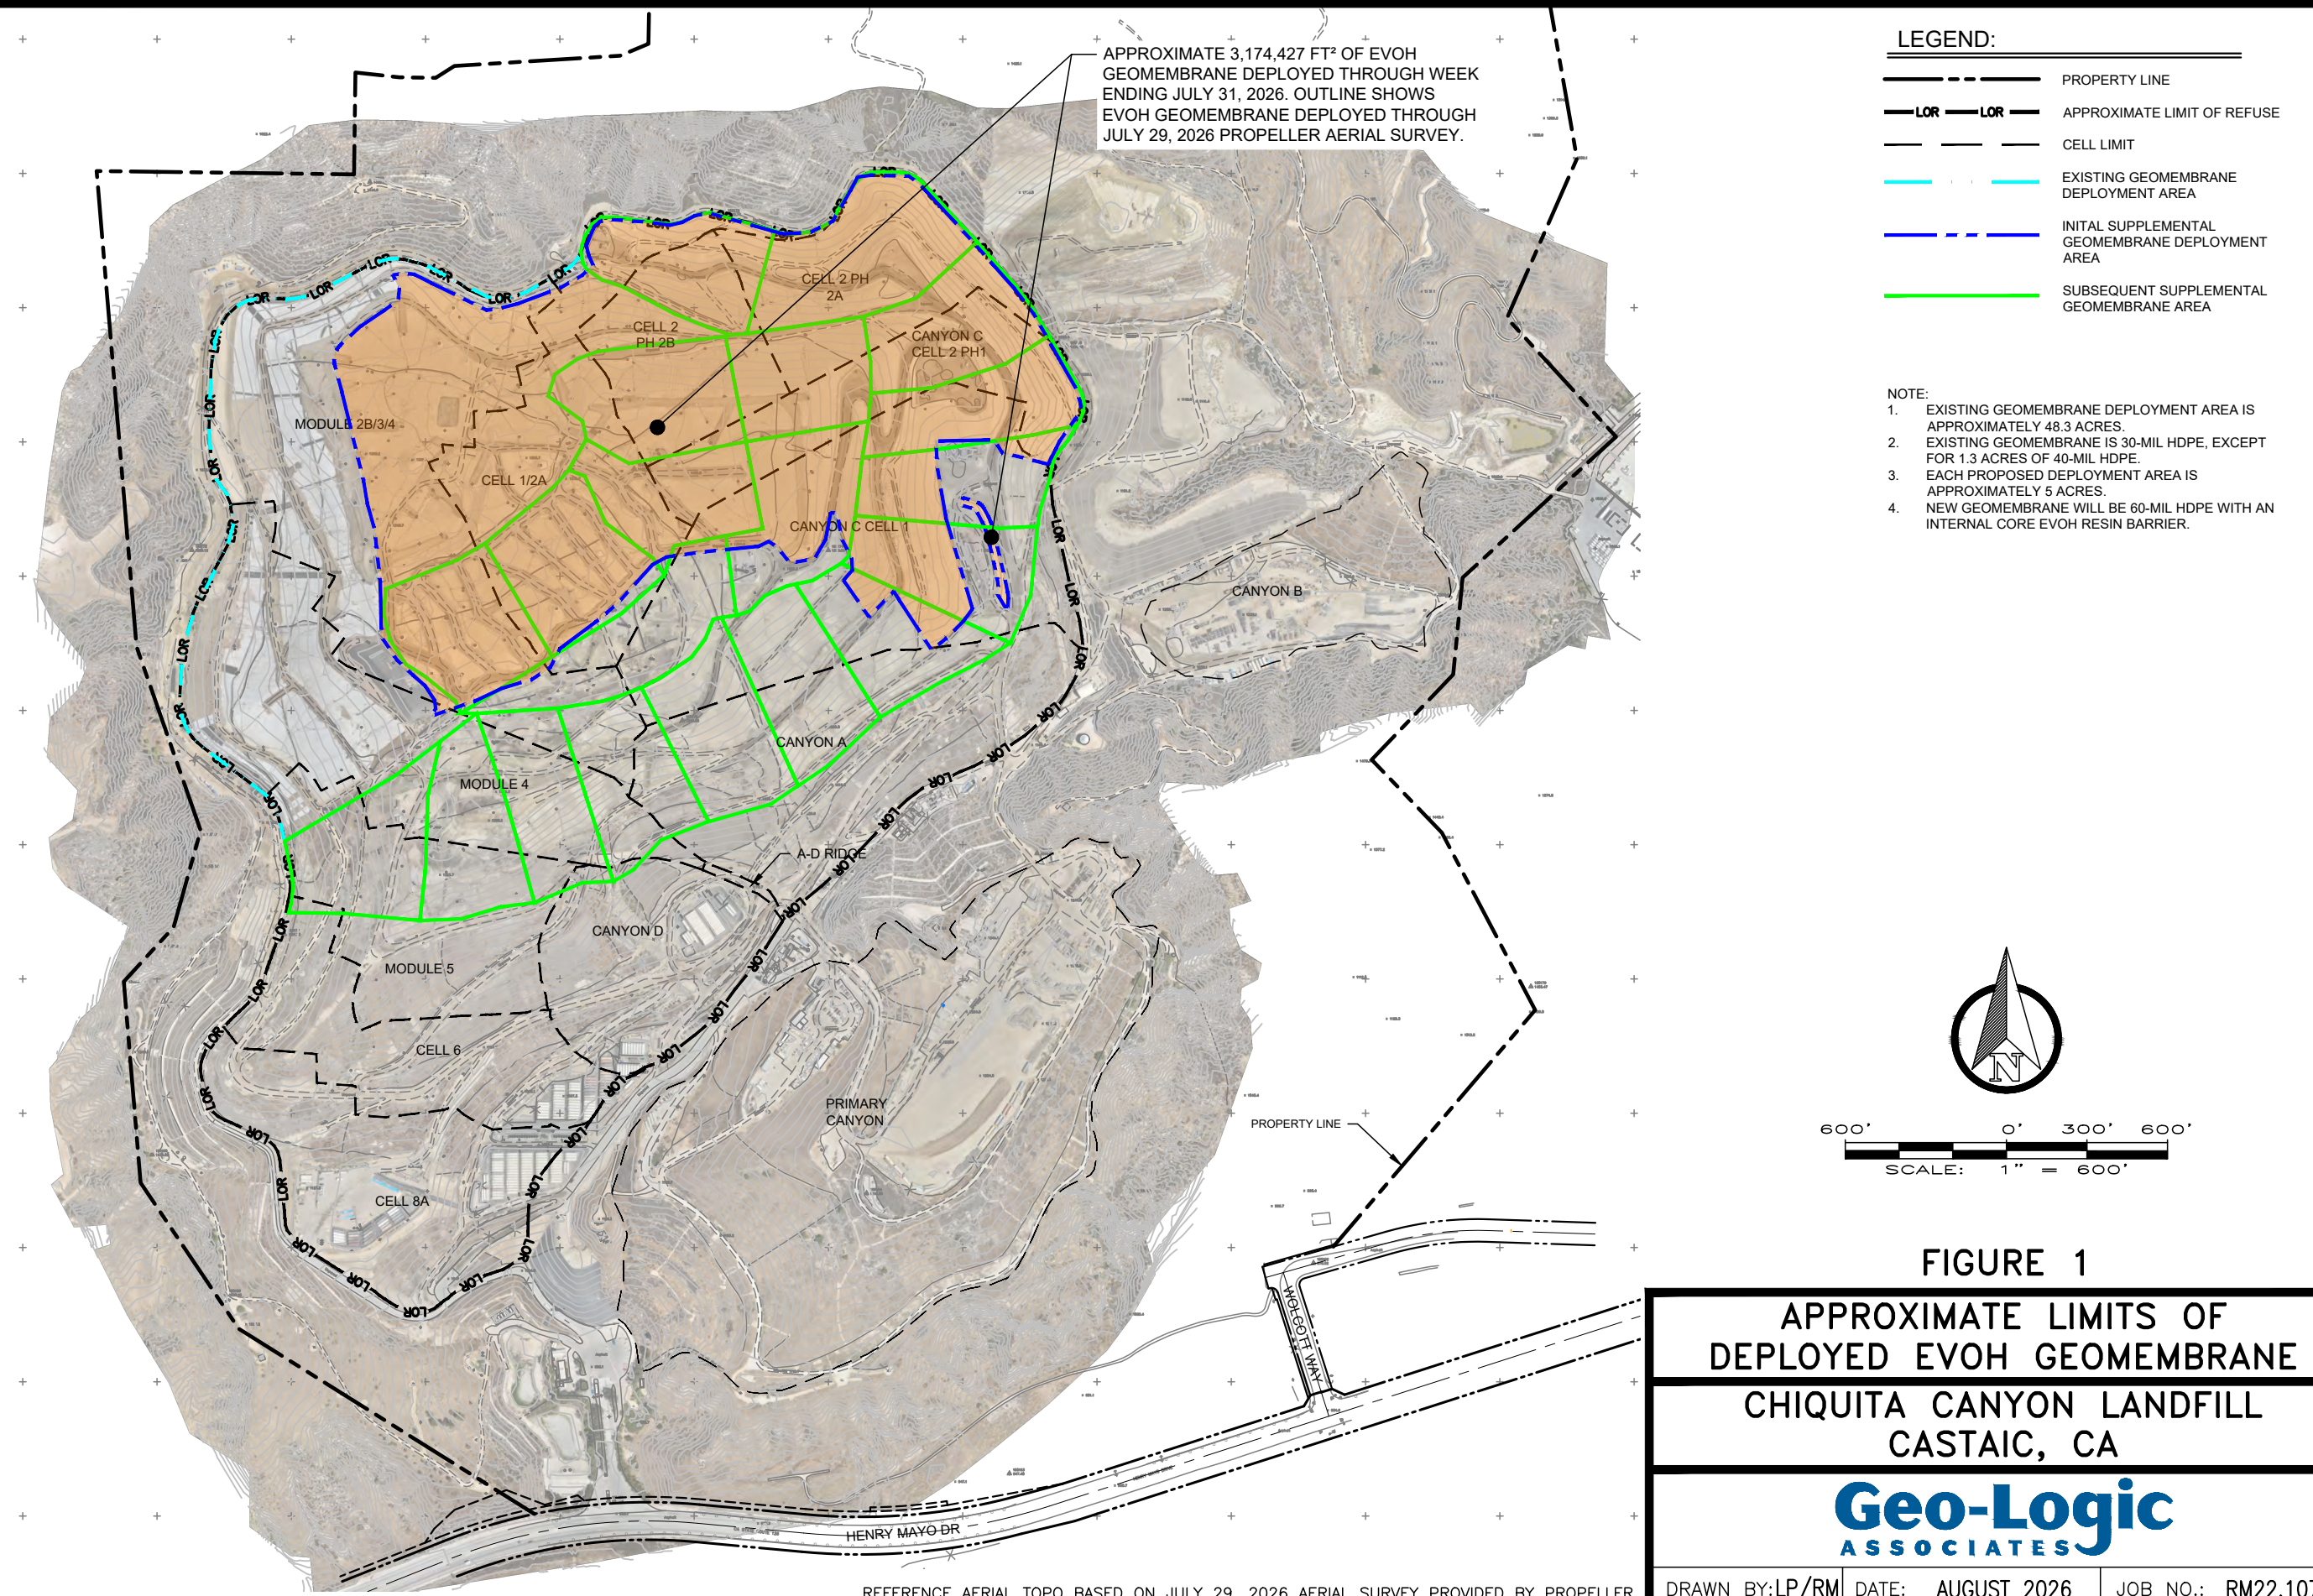

Chiquita Canyon Landfill -Isopach

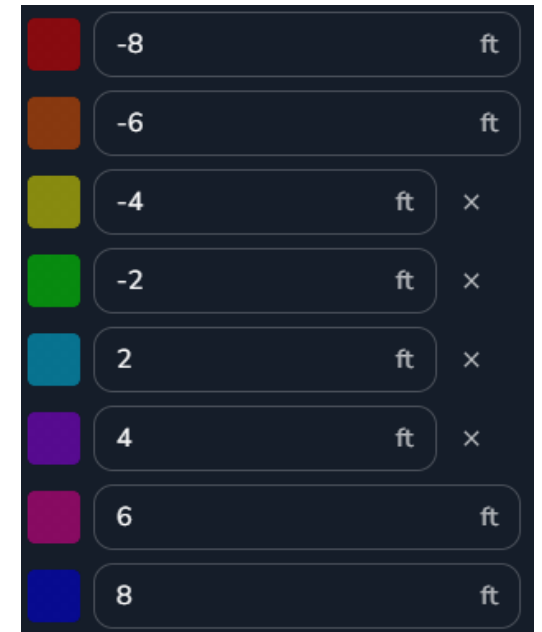

Jul 29, 2026 Survey Image. Jul 1, 2026 vs Jul 29, 2026