

From: WILLIAM.HALEY@WasteConnections.com
Sent: Friday, September 4, 2026 2:11 PM
To: Karen Gork
Cc: Todd.Thalhamer@Calrecycle.ca.gov; LFrias@ph.lacounty.gov; NQuick@ph.lacounty.gov; RRagland@ph.lacounty.gov; BMcphillips@counsel.lacounty.gov; Wes.Mindermann@CalRecycle.ca.gov; mark.debie@calrecycle.ca.gov; mark.debie@calrecycle.ca.gov; emorofuji@ph.lacounty.gov; btway@ph.lacounty.gov; Relon.MarkAnthony@epa.gov; Holybee.Tyler@epa.gov; Friedli.Laura@epa.gov; John Perkey; Sarah Phillips; Gregory.Shaffer@dtsc.ca.gov; Natasha.DiPietro@dtsc.ca.gov; Gregory.Gentile@dtsc.ca.gov; Dylan Smith
Subject: Re: Chiquita Canyon Landfill – Geosynthetic Cover – Mitigation Measure 4.1
Attachments: CCLF Reaction Area _Reactive Wells_2026-08-18.pdf; RM22.1077-CCL-EVOH-FIG 1-(2026-09-03)-FIG 1.pdf; Milestone 2B Chiquita Canyon LF Isopach_Aug.2026.pdf

Below is Chiquita’s weekly update on the status of the installation of the 60-mil EVOH/HDPE geomembrane cover at the Chiquita Canyon Landfill, in accordance with Mitigation Measure 4.1 of the LEA’s Compliance Order issued May 1, 2025.

As of August 28, 2026, D&E, on behalf of Chiquita, has installed approximately 3,709,290 square feet of tan 60-mil EVOH/HDPE geomembrane cover. Of this total, approximately 736,689 square feet has been deployed on top of the existing 30mil geomembrane to augment its effectiveness. Work conducted the week of August 24 also included repairs and detailing of existing panels, including boot fabrication, patching, extrusion welding, and re-seaming, as needed. Work continued during the week of August 31, 2026. Chiquita has included the below summary total of Liner quantities:

	New EVOH Liner Installed	EVOH over existing 30-mil Installed	Existing 30- mil Liner	Total Liner Coverage
8/7/2026	2,629,969	736,689	1,564,950	4,931,608
8/14/2026	2,752,615	736,689	1,564,950	5,054,254
8/21/2026	2,860,533	736,689	1,564,950	5,162,172
8/28/2026	2,972,601	736,689	1,564,950	5,274,240

The attached site map shows the approximate extent of geomembrane cover installed as of Wednesday, August 26, 2026, as well as the geomembrane coverage described in the revised draft workplan for extension of the geomembrane cover area submitted to the LEA, the US EPA, and DTSC on March 13, 2026. Also attached to this submission are the August 2026 monthly isopach map and a figure identifying wells showing signs of reaction as of August 18, 2026 based on the June Reaction Mitigation Area. Due to technical limitations, we are currently unable to create one figure including all of this data.

Thank you,

Bill Haley, PE


Sr. Project Engineer

O: 661.257.3655 | C: 661.964.5821


Waste Connections | 29201 Henry Mayo Dr. | Castaic, CA 91384

Connect With the Future © www.wasteconnections.com

P:\SITES\CHIQUITA CYN LF\MONITORING SUMMARY\FIGURES-WEEKLY\RM22.1077-CCL-EVOH-FIG 1-(2026-09-03).DWG September 3, 2026 - 10:59 AM BY: GLA-USER

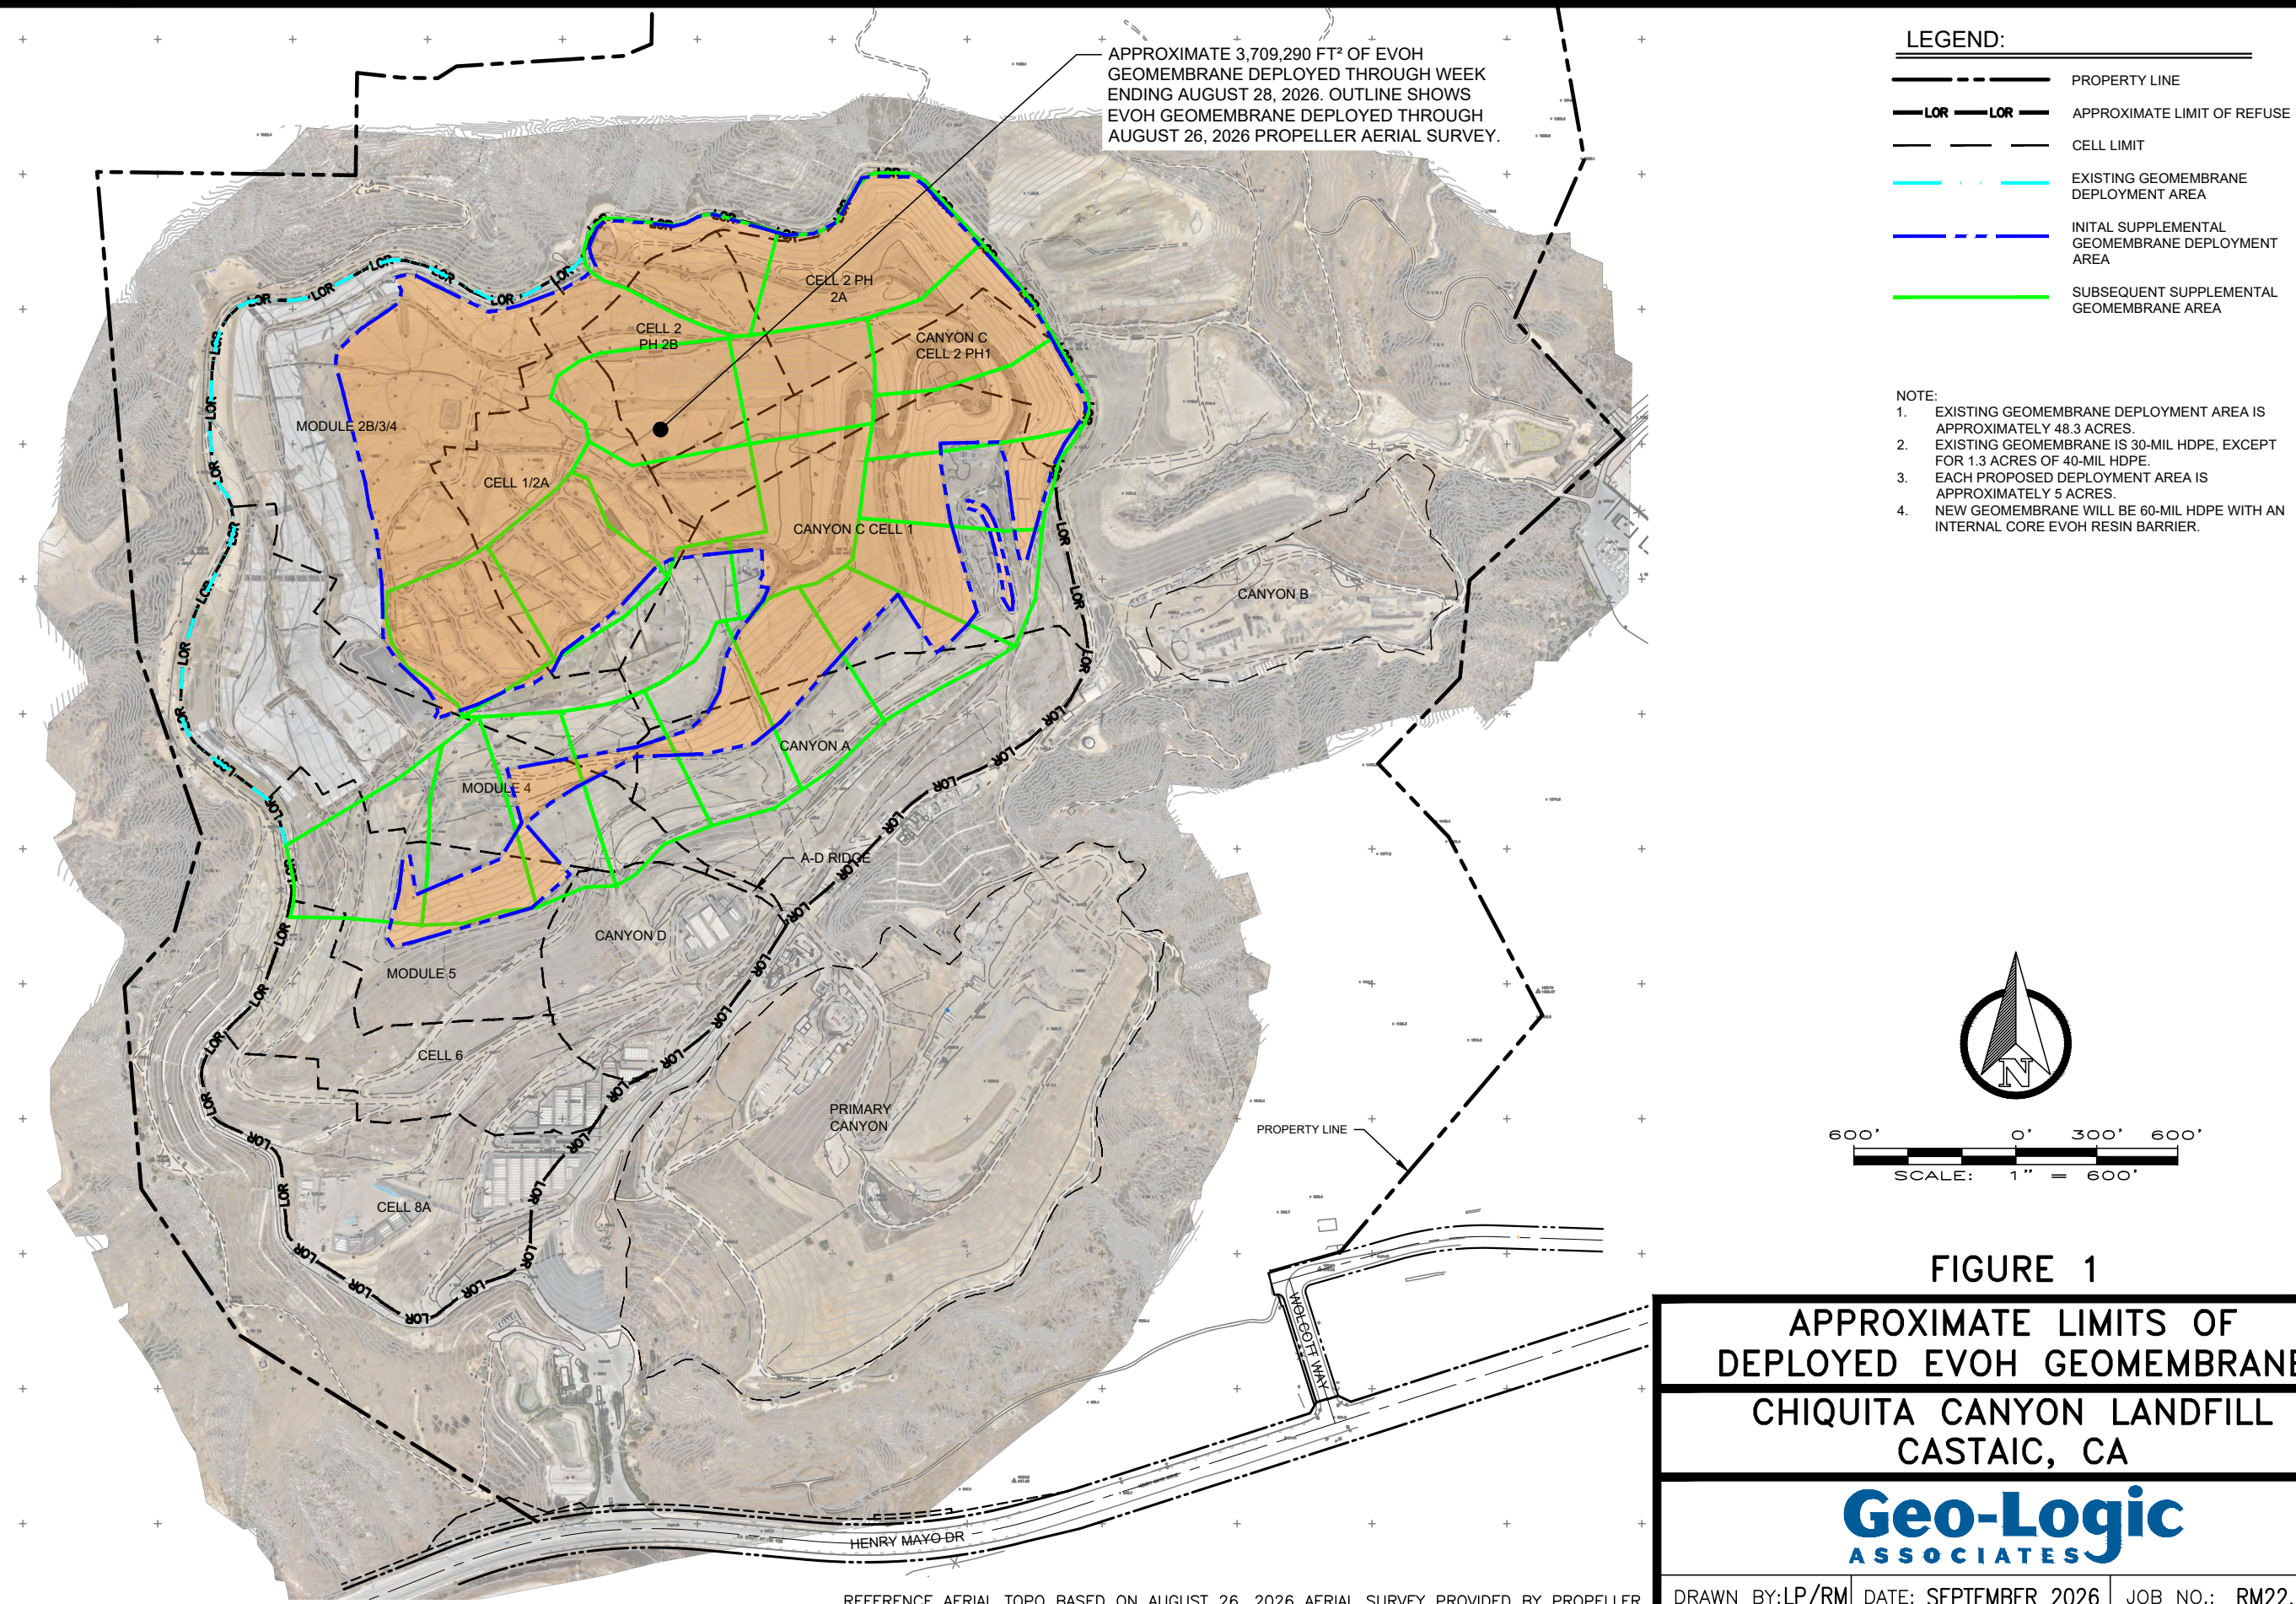

Chiquita Canyon Landfill -Isopach

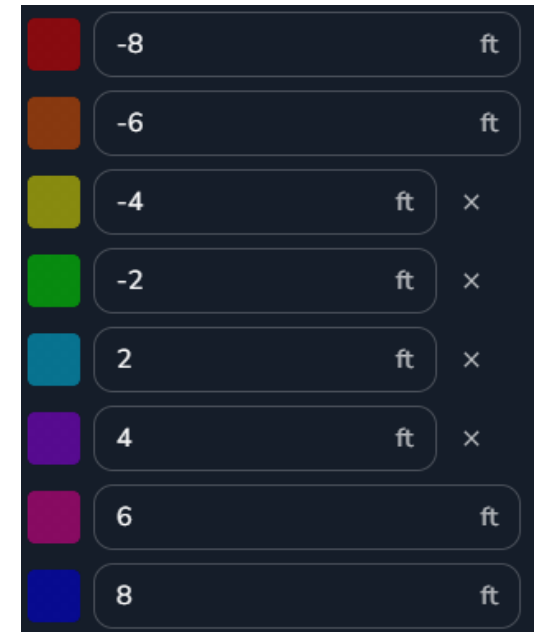

Aug 26, 2026 Survey Image. Aug 5, 2026 vs Aug 26, 2026