

De: Huber, Rachelle <RHuber@scsengineers.com>
Enviado: Viernes 25 de septiembre de 2026 5:09 PM
Para: "ndickel@aqmd.gov"; Christina Ojeda; "Baitong Chen"
Cc: Medina, Steven; Bill Haley; Viswanathan, Srividhya; Jones, Art; Mark.Adams; Dylan Smith; matthew.breuer@wasteconnections.com; Sarah Phillips; Kim, Jenny
Asunto: Orden de Depuración Estipulada del Caso No. 6177-4 - Actualización sobre la Perforación del Pozo
Adjuntos: 2026-09-25_CCLF_GCCS Expan Weekly Well Install Notification Map_v0.0.pdf

Según la Condición 15(c) de la Orden Estipulada, a continuación, se encuentra el resumen actualizado de la construcción para el Proyecto del Plan Maestro de Ampliación de GCCS 2026 del Vertedero de Chiquita Canyon.

Del 21/09/2026 al 25/09/2026, Chiquita completó la instalación de dos (2) pozos de extracción vertical de LFG. La cantidad total de pozos verticales de extracción de LFG instalados desde el 6 de diciembre de 2023 (la fecha de inicio de la Expansión Maestra de GCCS) hasta hoy es de trescientos cuarenta y uno (341).

Los pozos programados para perforación durante la semana del 28/09/2026 al 02/10/2026 son los siguientes (sujeto a cambios):

Plataforma (Secuencia): CV-2604, CV-2668, CV-2673, CV-2674S/D, CV-2678S/D

Las ubicaciones de las instalaciones de los pozos programadas para perforar la semana que viene están sujetas a cambios debido a los tiempos de inactividad de la plataforma, a las condiciones climáticas y/o de seguridad.

Atentamente,



Rachelle Huber

Gerente de Proyectos

rhuber@scsengineers.com



O: 562-356-1068

C: 925-789-5710

4683 Chabot Drive, Suite 200

Pleasanton, CA 94588



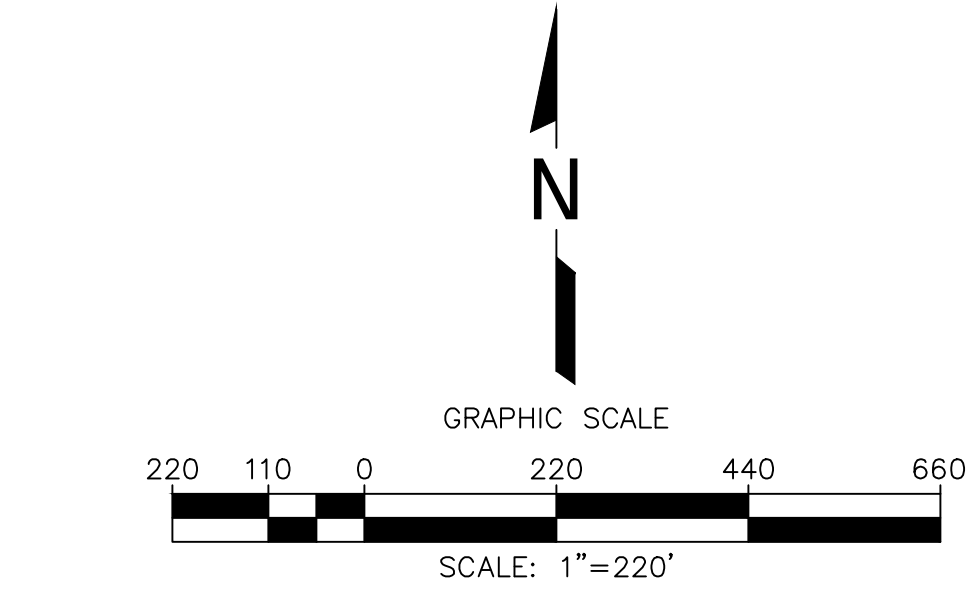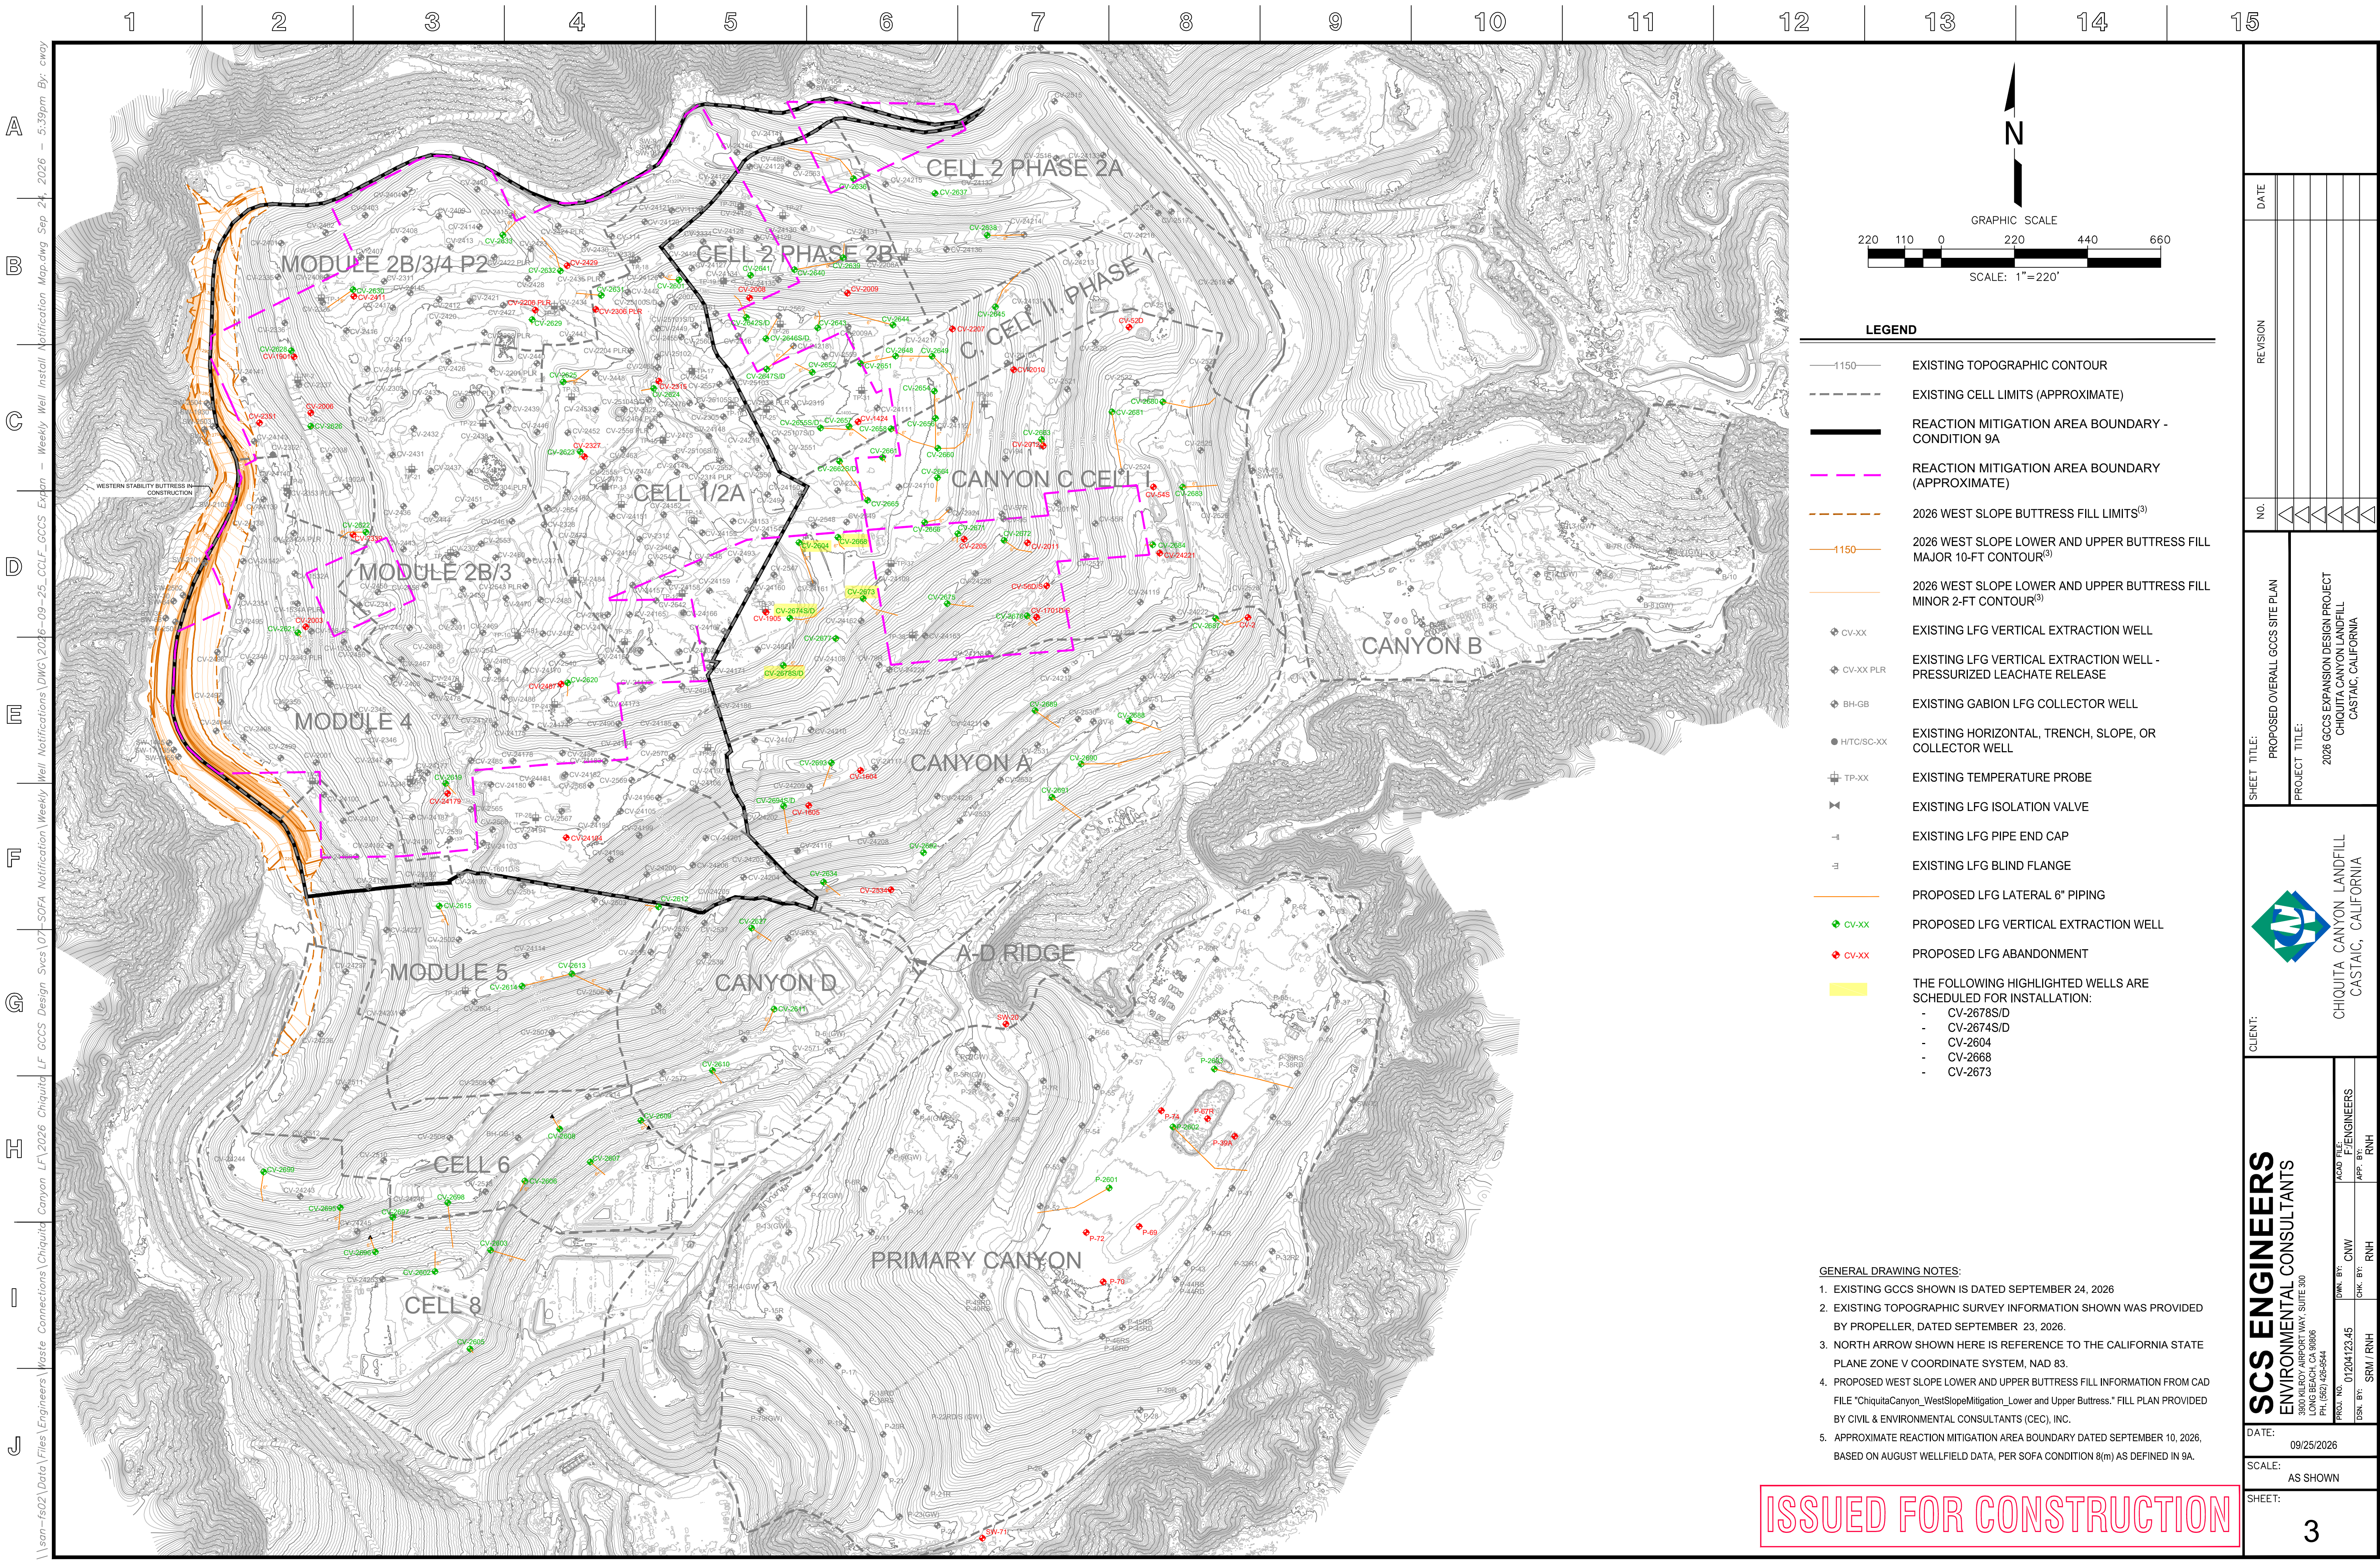

LEGEND	
	EXISTING TOPOGRAPHIC CONTOUR
	EXISTING CELL LIMITS (APPROXIMATE)
	REACTION MITIGATION AREA BOUNDARY - CONDITION 9A
	REACTION MITIGATION AREA BOUNDARY (APPROXIMATE)
	2026 WEST SLOPE BUTTRESS FILL LIMITS ⁽³⁾
	2026 WEST SLOPE LOWER AND UPPER BUTTRESS FILL MAJOR 10-FT CONTOUR ⁽³⁾
	2026 WEST SLOPE LOWER AND UPPER BUTTRESS FILL MINOR 2-FT CONTOUR ⁽³⁾
	EXISTING LFG VERTICAL EXTRACTION WELL
	EXISTING LFG VERTICAL EXTRACTION WELL - PRESSURIZED LEACHATE RELEASE
	EXISTING GABION LFG COLLECTOR WELL
	EXISTING HORIZONTAL, TRENCH, SLOPE, OR COLLECTOR WELL
	EXISTING TEMPERATURE PROBE
	EXISTING LFG ISOLATION VALVE
	EXISTING LFG PIPE END CAP
	EXISTING LFG BLIND FLANGE
	PROPOSED LFG LATERAL 6" PIPING
	PROPOSED LFG VERTICAL EXTRACTION WELL
	PROPOSED LFG ABANDONMENT
	THE FOLLOWING HIGHLIGHTED WELLS ARE SCHEDULED FOR INSTALLATION: - CV-2678S/D - CV-2674S/D - CV-2604 - CV-2668 - CV-2673

- GENERAL DRAWING NOTES:
- EXISTING GCCS SHOWN IS DATED SEPTEMBER 24, 2026
 - EXISTING TOPOGRAPHIC SURVEY INFORMATION SHOWN WAS PROVIDED BY PROPELLER, DATED SEPTEMBER 23, 2026.
 - NORTH ARROW SHOWN HERE IS REFERENCE TO THE CALIFORNIA STATE PLANE ZONE V COORDINATE SYSTEM, NAD 83.
 - PROPOSED WEST SLOPE LOWER AND UPPER BUTTRESS FILL INFORMATION FROM CAD FILE "ChiquitaCanyon_WestSlopeMitigation_Lower and Upper Buttress." FILL PLAN PROVIDED BY CIVIL & ENVIRONMENTAL CONSULTANTS (CEC), INC.
 - APPROXIMATE REACTION MITIGATION AREA BOUNDARY DATED SEPTEMBER 10, 2026, BASED ON AUGUST WELLFIELD DATA, PER SOFA CONDITION 8(m) AS DEFINED IN 9A.

ISSUED FOR CONSTRUCTION

DATE	REVISION	NO.	SHEET TITLE:	PROJECT TITLE:	CLIENT:	SCS ENGINEERS ENVIRONMENTAL CONSULTANTS 10000 S. DEER CANYON WAY, SUITE 300 LONG BEACH, CA 90806 PH: (562) 426-9544	DWG. BY: CNW	CHK. BY: RNH	DATE:	SCALE:	SHEET:
			PROPOSED OVERALL GCCS SITE PLAN	2026 GCCS EXPANSION DESIGN PROJECT CHIUQUITA CANYON LANDFILL CASTAIC, CALIFORNIA					09/25/2026	AS SHOWN	3