

From: WILLIAM.HALEY@WasteConnections.com
Sent: Friday, October 2, 2026 1:56 PM
To: Karen Gork
Cc: Todd.Thalhamer@Calrecycle.ca.gov; LFrias@ph.lacounty.gov; NQuick@ph.lacounty.gov; RRagland@ph.lacounty.gov; BMcphillips@counsel.lacounty.gov; Wes.Mindermann@CalRecycle.ca.gov; mark.debie@calrecycle.ca.gov; mark.debie@calrecycle.ca.gov; emorofuji@ph.lacounty.gov; btway@ph.lacounty.gov; Relon.MarkAnthony@epa.gov; Holybee.Tyler@epa.gov; Friedli.Laura@epa.gov; John Perkey; Sarah Phillips; Gregory.Shaffer@dtsc.ca.gov; Natasha.DiPietro@dtsc.ca.gov; Gregory.Gentile@dtsc.ca.gov; Dylan Smith
Subject: Re: Chiquita Canyon Landfill – Geosynthetic Cover – Mitigation Measure 4.1
Attachments: 2026-09-14_CCLF Reaction Area - Reactive Wells - August_V1.0.pdf; Milestone 2B Chiquita Canyon LF Isopach_Sep.2026.pdf; RM22.1077-CCL-EVOH-FIG 1-(2026-09-25)-FIG 1.pdf

Below is Chiquita’s weekly update on the status of the installation of the 60-mil EVOH/HDPE geomembrane cover at the Chiquita Canyon Landfill, in accordance with Mitigation Measure 4.1 of the LEA’s Compliance Order issued May 1, 2025.

As of September 25, 2026, D&E, on behalf of Chiquita, has installed approximately 4,148,475 square feet of tan 60-mil EVOH/HDPE geomembrane cover. Of this total, approximately 736,689 square feet has been deployed on top of the existing 30mil geomembrane to augment its effectiveness. Work conducted the week of September 21 also included repairs and detailing of existing panels, including boot fabrication, patching, extrusion welding, and re-seaming, as needed. Work continued during the week of September 28, 2026. Chiquita has included the below summary total of Liner quantities:

	New EVOH Liner Installed	EVOH over existing 30-mil Installed	Existing 30- mil Liner	Total Liner Coverage
8/7/2026	2,629,969	736,689	1,564,950	4,931,608
8/14/2026	2,752,615	736,689	1,564,950	5,054,254
8/21/2026	2,860,533	736,689	1,564,950	5,162,172
8/28/2026	2,972,601	736,689	1,564,950	5,274,240
9/4/2026	3,070,743	736,689	1,564,950	5,372,382
9/11/2026	3,130,545	736,689	1,564,950	5,432,184
9/18/2026	3,232,497	736,689	1,564,950	5,534,136
9/25/2026	3,411,786	736,689	1,564,950	5,713,425

The attached site map shows the approximate extent of geomembrane cover installed as of Wednesday, September 25, 2026, as well as the geomembrane coverage described in the revised draft workplan for extension of the geomembrane cover area submitted to the LEA, the US EPA, and DTSC on March 13, 2026. Also attached to this submission are the September

2026 monthly isopach map and a figure identifying wells showing signs of reaction as of September 14, 2026 based on the June Reaction Mitigation Area. Due to technical limitations, we are currently unable to create one figure including all of this data.

Thank you,


Bill Haley, PE

Sr. Project Engineer


O: 661.257.3655 | C: 661.964.5821

Chiquita Canyon Landfill | 29201 Henry Mayo Dr. | Castaic, CA 91384

Connect With the Future © www.wasteconnections.com

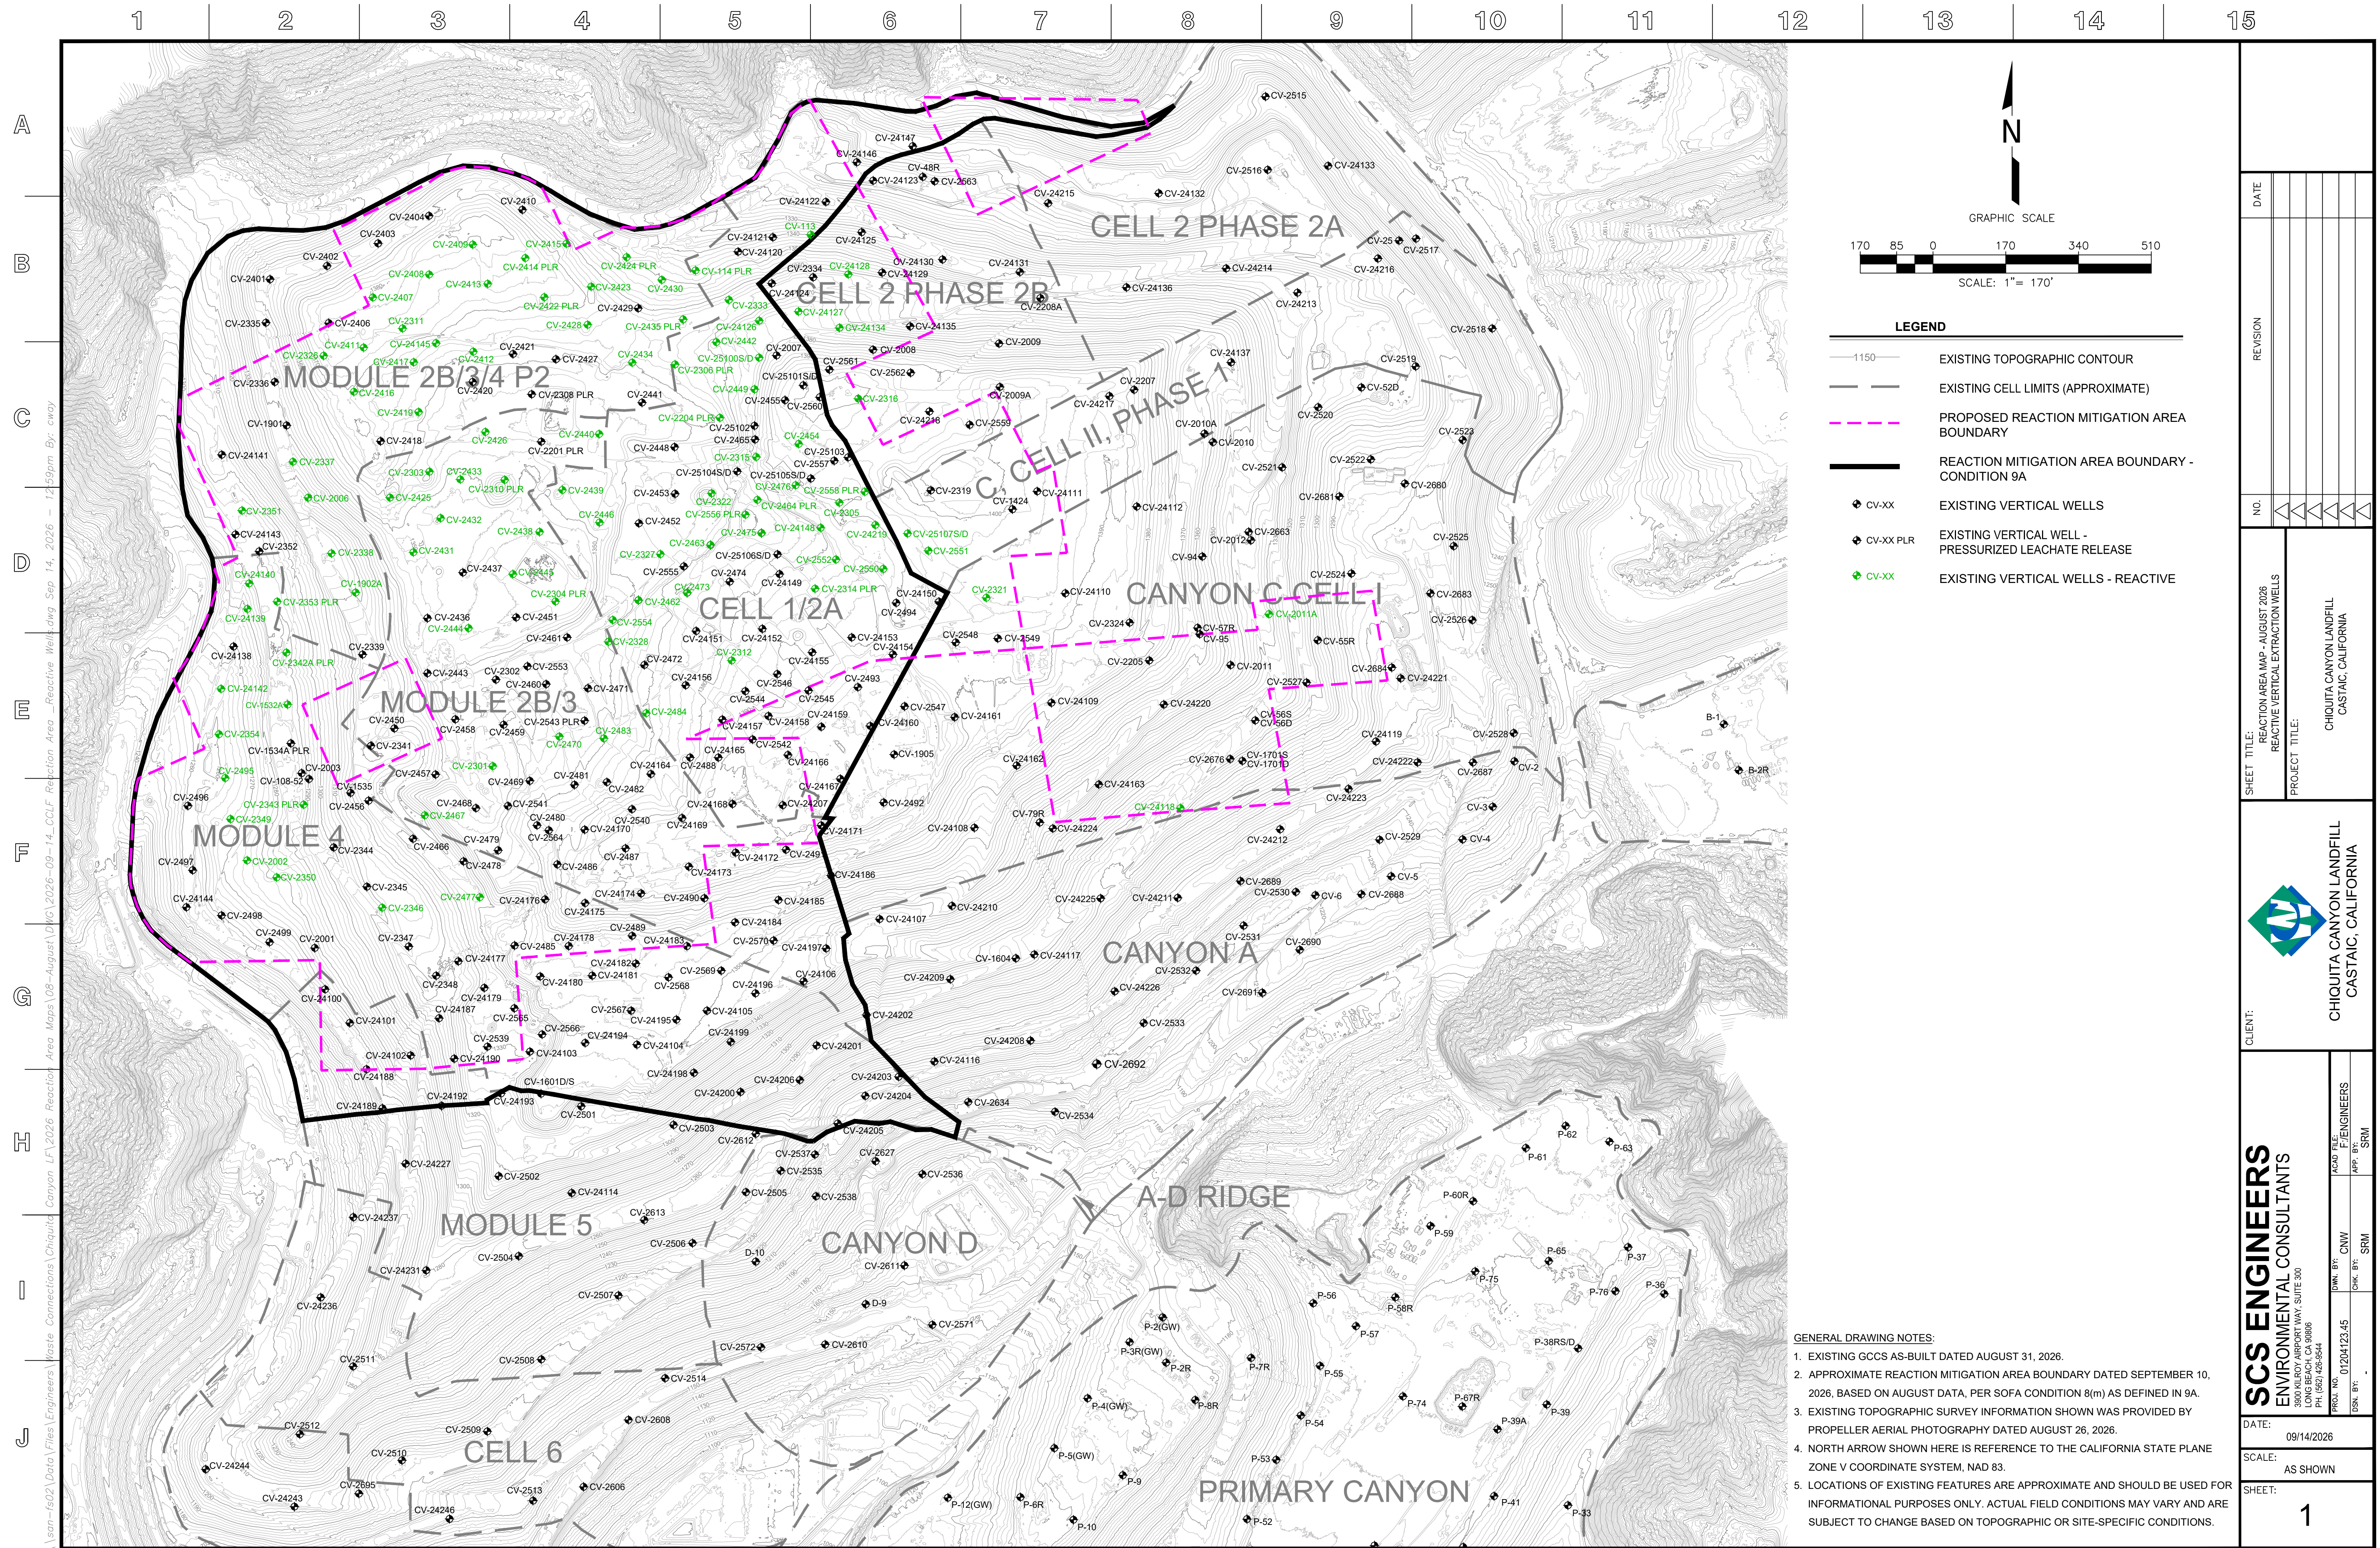

Chiquita Canyon Landfill -Isopach

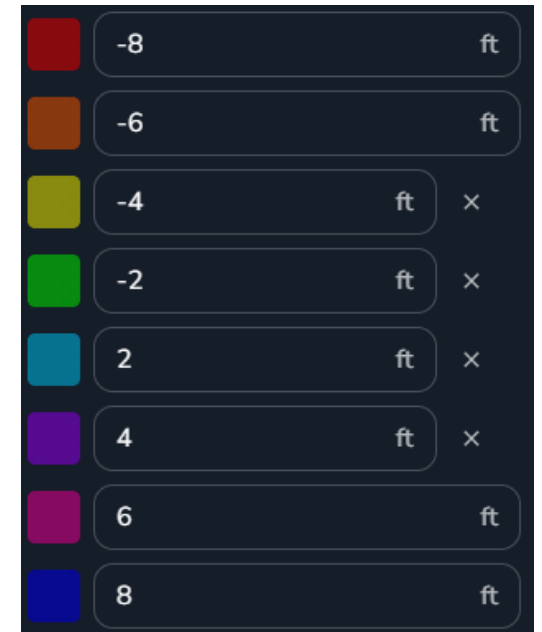

Sep 30, 2026 Survey Image. Sep 2, 2026 vs Sep 30, 2026

P:\SITES\CHIQUITA CYN LF\MONITORING SUMMARY\FIGURES-WEEKLY\RM22.1077-CCL-EVOH-FIG 1-(2026-09-25).DWG September 25, 2026 - 9:35 AM BY: GLA-USER

