De: WILLIAM.HALEY@WasteConnections.com
Enviado: viernes 9 de octubre de 2026 4:27 PM
Para: Karen Gork
Cc: Todd.Thalhamer@Calrecycle.ca.gov; LFrias@ph.lacounty.gov; NQuick@ph.lacounty.gov; RRagland@ph.lacounty.gov; BMcphillips@counsel.lacounty.gov; Wes.Mindermann@CalRecycle.ca.gov; mark.debie@calrecycle.ca.gov; mark.debie@calrecycle.ca.gov; emorofuji@ph.lacounty.gov; btway@ph.lacounty.gov; Relon.MarkAnthony@epa.gov; Holybee.Tyler@epa.gov; Friedli.Laura@epa.gov; John Perkey; Sarah Phillips; Gregory.Shaffer@dtsc.ca.gov; Natasha.DiPietro@dtsc.ca.gov; Gregory.Gentile@dtsc.ca.gov; Dylan Smith
Asunto: Re: Vertedero de Chiquita Canyon – Cubierta Geosintética – Medida de Mitigación 4.1
Adjuntos: 2026-09-14_CCLF Reaction Area - Reactive Wells - August_V1.0.pdf; Milestone 2B Chiquita Canyon LF Isopach_Sep.2026.pdf; RM22.1077-CCL-EVOH-FIG 1-(2026-10-09)-FIG 1.pdf

A continuación, se encuentra la actualización semanal de Chiquita sobre el estado de la instalación de la cubierta de geomembrana de EVOH/HDPE de 60 milésimas de pulgada en el Vertedero de Chiquita Canyon, conforme a la Medida de Mitigación 4.1 de la Orden de Cumplimiento de la LEA emitida el 1 de mayo de 2025.

Al 2 de octubre de 2026, D&E, en nombre de Chiquita, instaló aproximadamente 4,168,230 pies cuadrados de cubierta de geomembrana de EVOH/HDPE marrón claro de 60 milésimas de pulgada. De este total, se desplegaron aproximadamente 756,444 pies cuadrados sobre la geomembrana existente de 30 milésimas de pulgada para aumentar su efectividad. La obra realizada la semana del 28 de septiembre incluyó amplias reparaciones y detallado de los paneles existentes, incluida la fabricación de botas, el emparchado, la soldadura por extrusión, la recostura y la colocación de bolsas de arena, según fuera necesario. El trabajo continuó durante la semana del 5 de octubre de 2026. Chiquita ha incluido el resumen a continuación con las cantidades totales de Revestimiento:


	Revestimiento de EVOH Nuevo Instalado	Revestimiento de EVOH Instalado sobre revestimiento de 30 milésimas de pulgada existente	Revestimiento de 30 milésimas de pulgada existente	Cobertura de Revestimiento Total
7/8/2026	2,629,969	736,689	1,564,950	4,931,608
14/8/2026	2,752,615	736,689	1,564,950	5,054,254
21/8/2026	2,860,533	736,689	1,564,950	5,162,172
28/8/2026	2,972,601	736,689	1,564,950	5,274,240
4/9/2026	3,070,743	736,689	1,564,950	5,372,382
11/9/2026	3,130,545	736,689	1,564,950	5,432,184
18/9/2026	3,232,497	736,689	1,564,950	5,534,136
25/9/2026	3,411,786	736,689	1,564,950	5,713,425
2/10/2026	3,392,031	756,444	1,545,195	5,693,670

El mapa del sitio adjunto muestra la extensión aproximada de la cubierta de geomembrana instalada al miércoles 7 de octubre de 2026, como también la cubierta de geomembrana descrita en el borrador revisado del plan de trabajo para la extensión del área de la cubierta de geomembrana presentado a la LEA, a la US EPA y al DTSC el 13 de marzo de 2026. También se adjuntan a esta entrega el mapa isopáquico mensual de septiembre

de 2026 y una figura que identifica los pozos que muestran indicios de reacción al 14 de septiembre de 2026 en base a la Zona de Mitigación de Reacciones de junio. Debido a limitaciones técnicas, actualmente no podemos crear una figura que incluya todos estos datos.

Gracias,

Bill Haley, PE
Ingeniero de Proyectos Sénior
O: 661.257.3655 | C: 661.964.5821
Vertedero de Chiquita Canyon | 29201 Henry Mayo Dr. | Castaic, CA 91384
Connect With the Future © *www.wasteconnections.com*

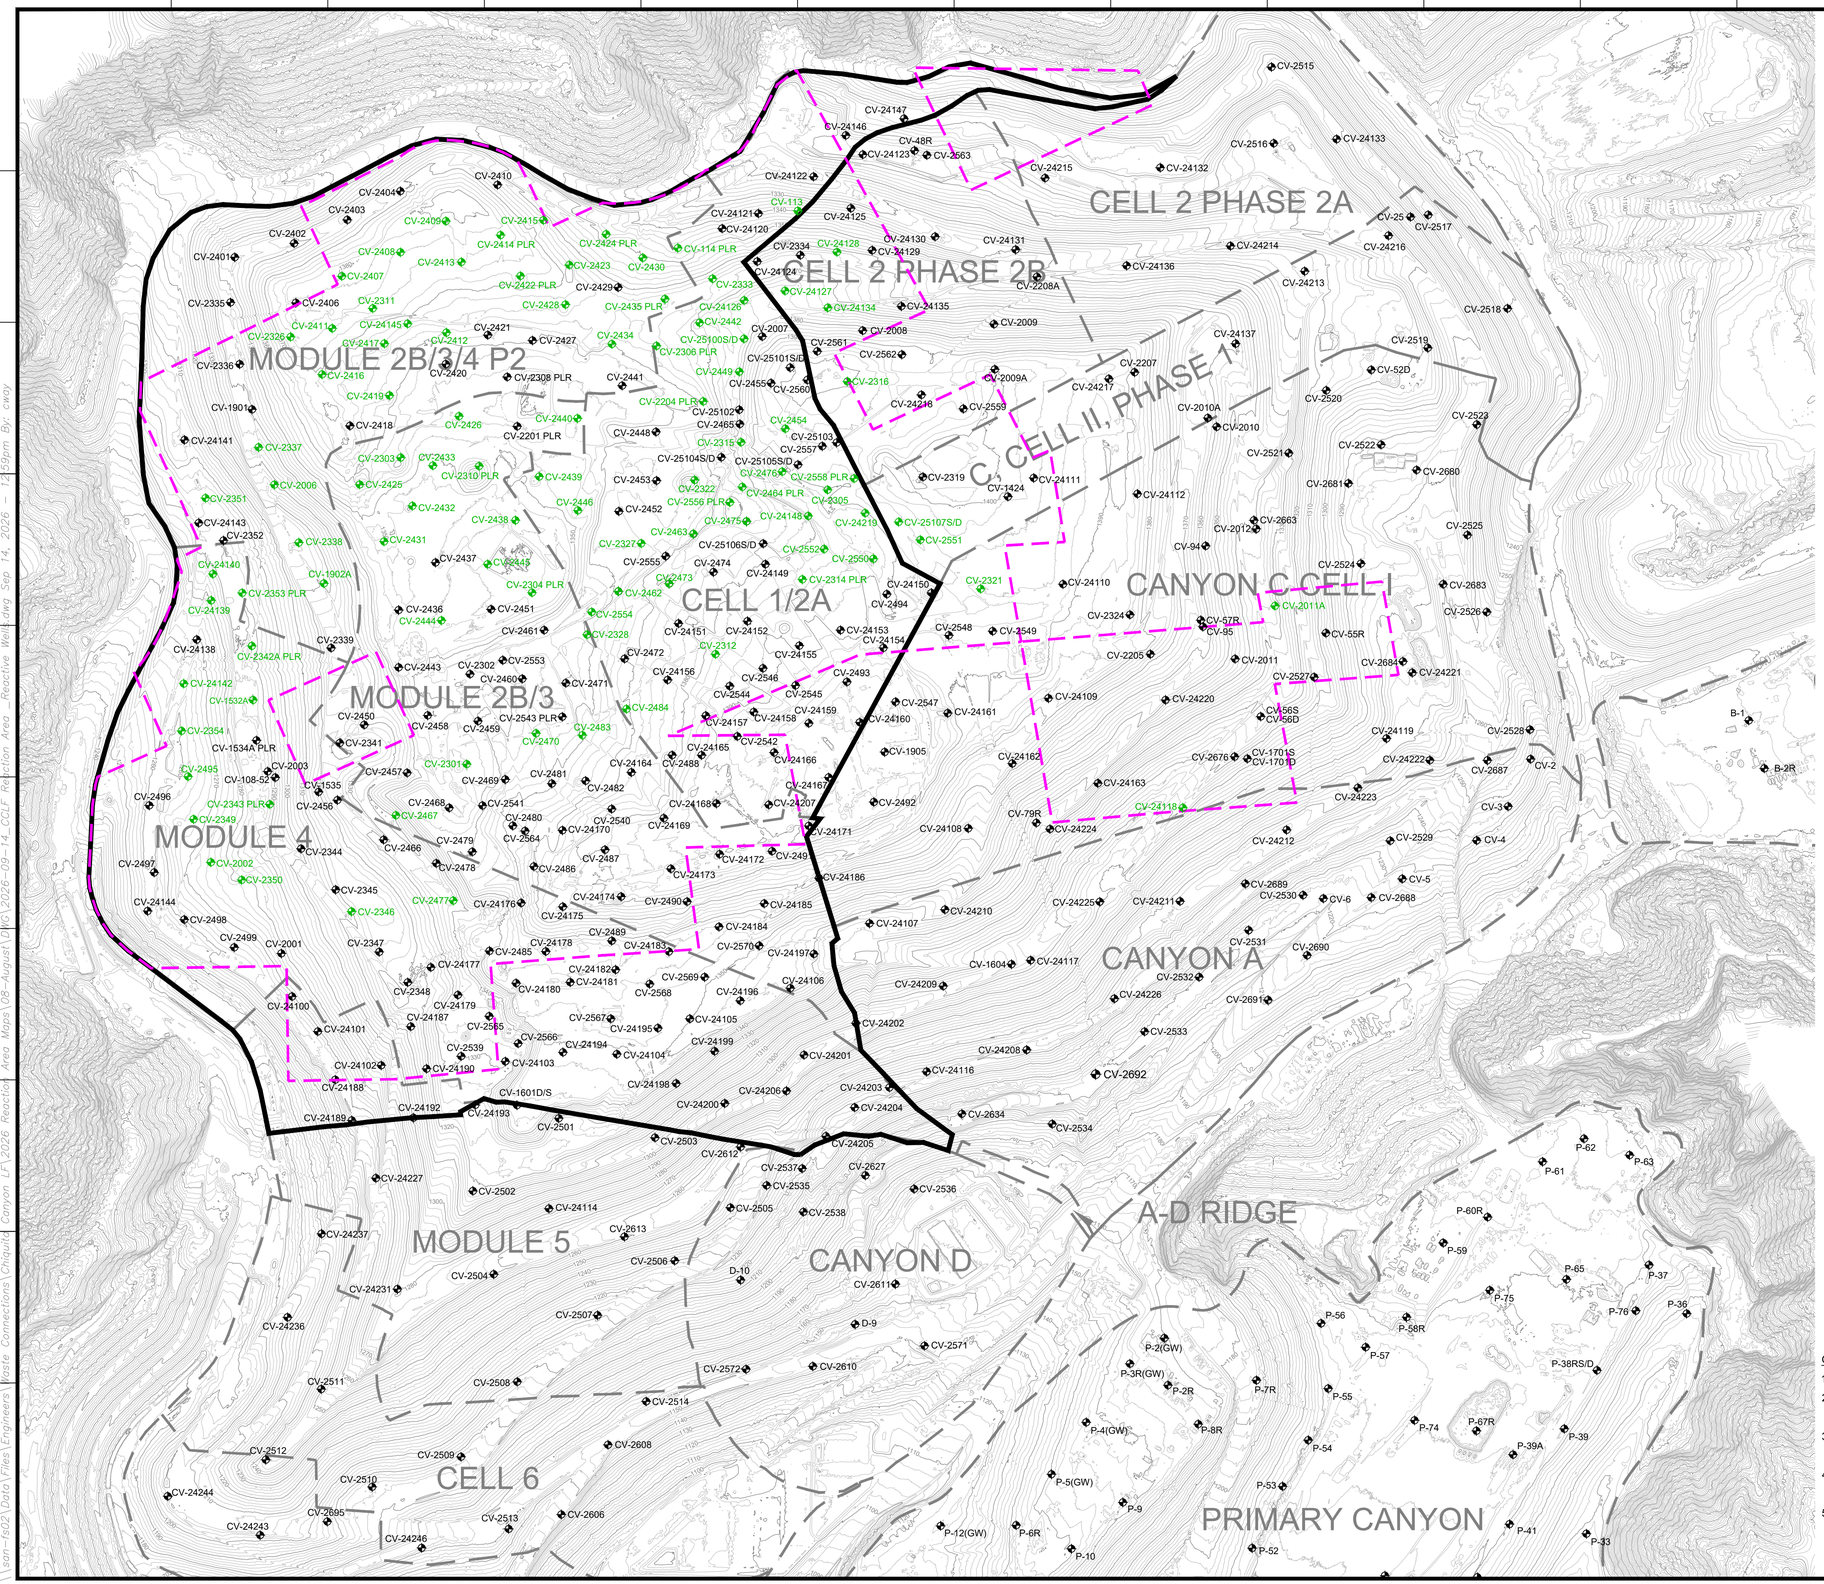

GENERAL DRAWING NOTES:

1. EXISTING GCCS AS-BUILT DATED AUGUST 31, 2026.
2. APPROXIMATE REACTION MITIGATION AREA BOUNDARY DATED SEPTEMBER 10, 2026, BASED ON AUGUST DATA, PER SOFA CONDITION 8(m) AS DEFINED IN 9A.
3. EXISTING TOPOGRAPHIC SURVEY INFORMATION SHOWN WAS PROVIDED BY PROPELLER AERIAL PHOTOGRAPHY DATED AUGUST 26, 2026.
4. NORTH ARROW SHOWN HERE IS REFERENCE TO THE CALIFORNIA STATE PLANE ZONE V COORDINATE SYSTEM, NAD 83.
5. LOCATIONS OF EXISTING FEATURES ARE APPROXIMATE AND SHOULD BE USED FOR INFORMATIONAL PURPOSES ONLY. ACTUAL FIELD CONDITIONS MAY VARY AND ARE SUBJECT TO CHANGE BASED ON TOPOGRAPHIC OR SITE-SPECIFIC CONDITIONS.

NO. | REVISION | DATE

SHEET TITLE: REACTION AREA MAP - AUGUST 2026
REACTIVE VERTICAL EXTRACTION WELLS

PROJECT TITLE: CHIQUITA CANYON LANDFILL
CASTAIC, CALIFORNIA

CLIENT: CHIQUITA CANYON LANDFILL
CASTAIC, CALIFORNIA

SCS ENGINEERS
ENVIRONMENTAL CONSULTANTS
3900 KILROY AIRPORT WAY, SUITE 300
LONG BEACH, CA 90806
PH: (562) 426-9544

PROJ. NO: 01204123.45 | DSN. BY: - | DWN. BY: CNW | CHK. BY: SRM | APP. BY: SRM | ACAD FILE: ENGINEERS


DATE: 09/14/2026


SCALE: AS SHOWN

SHEET: 1


\\scs-fs02\Data\Files\Engineers\Waste Connections\Chiquita Canyon LFI\2026 Reaction Area Maps\08-August\01\2026-09-14_CCLF Reaction Area _Reactive Wells.dwg Sep 14, 2026 - 12:59pm By: cwoy

Chiquita Canyon Landfill -Isopach

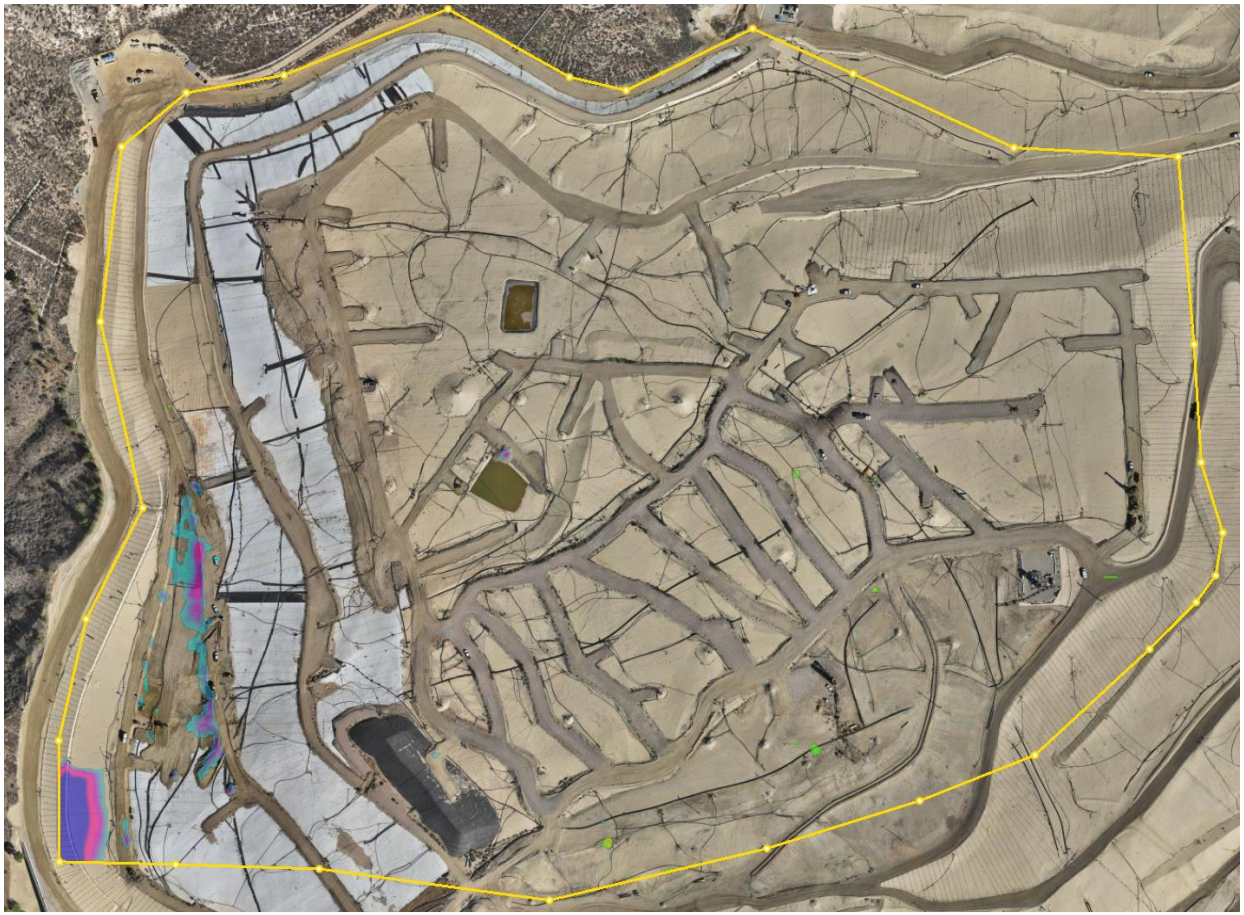

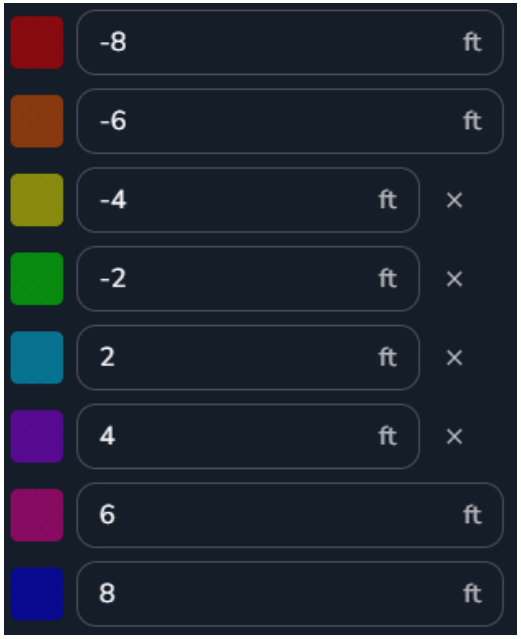

Sep 30, 2026 Survey Image. Sep 2, 2026 vs Sep 30, 2026

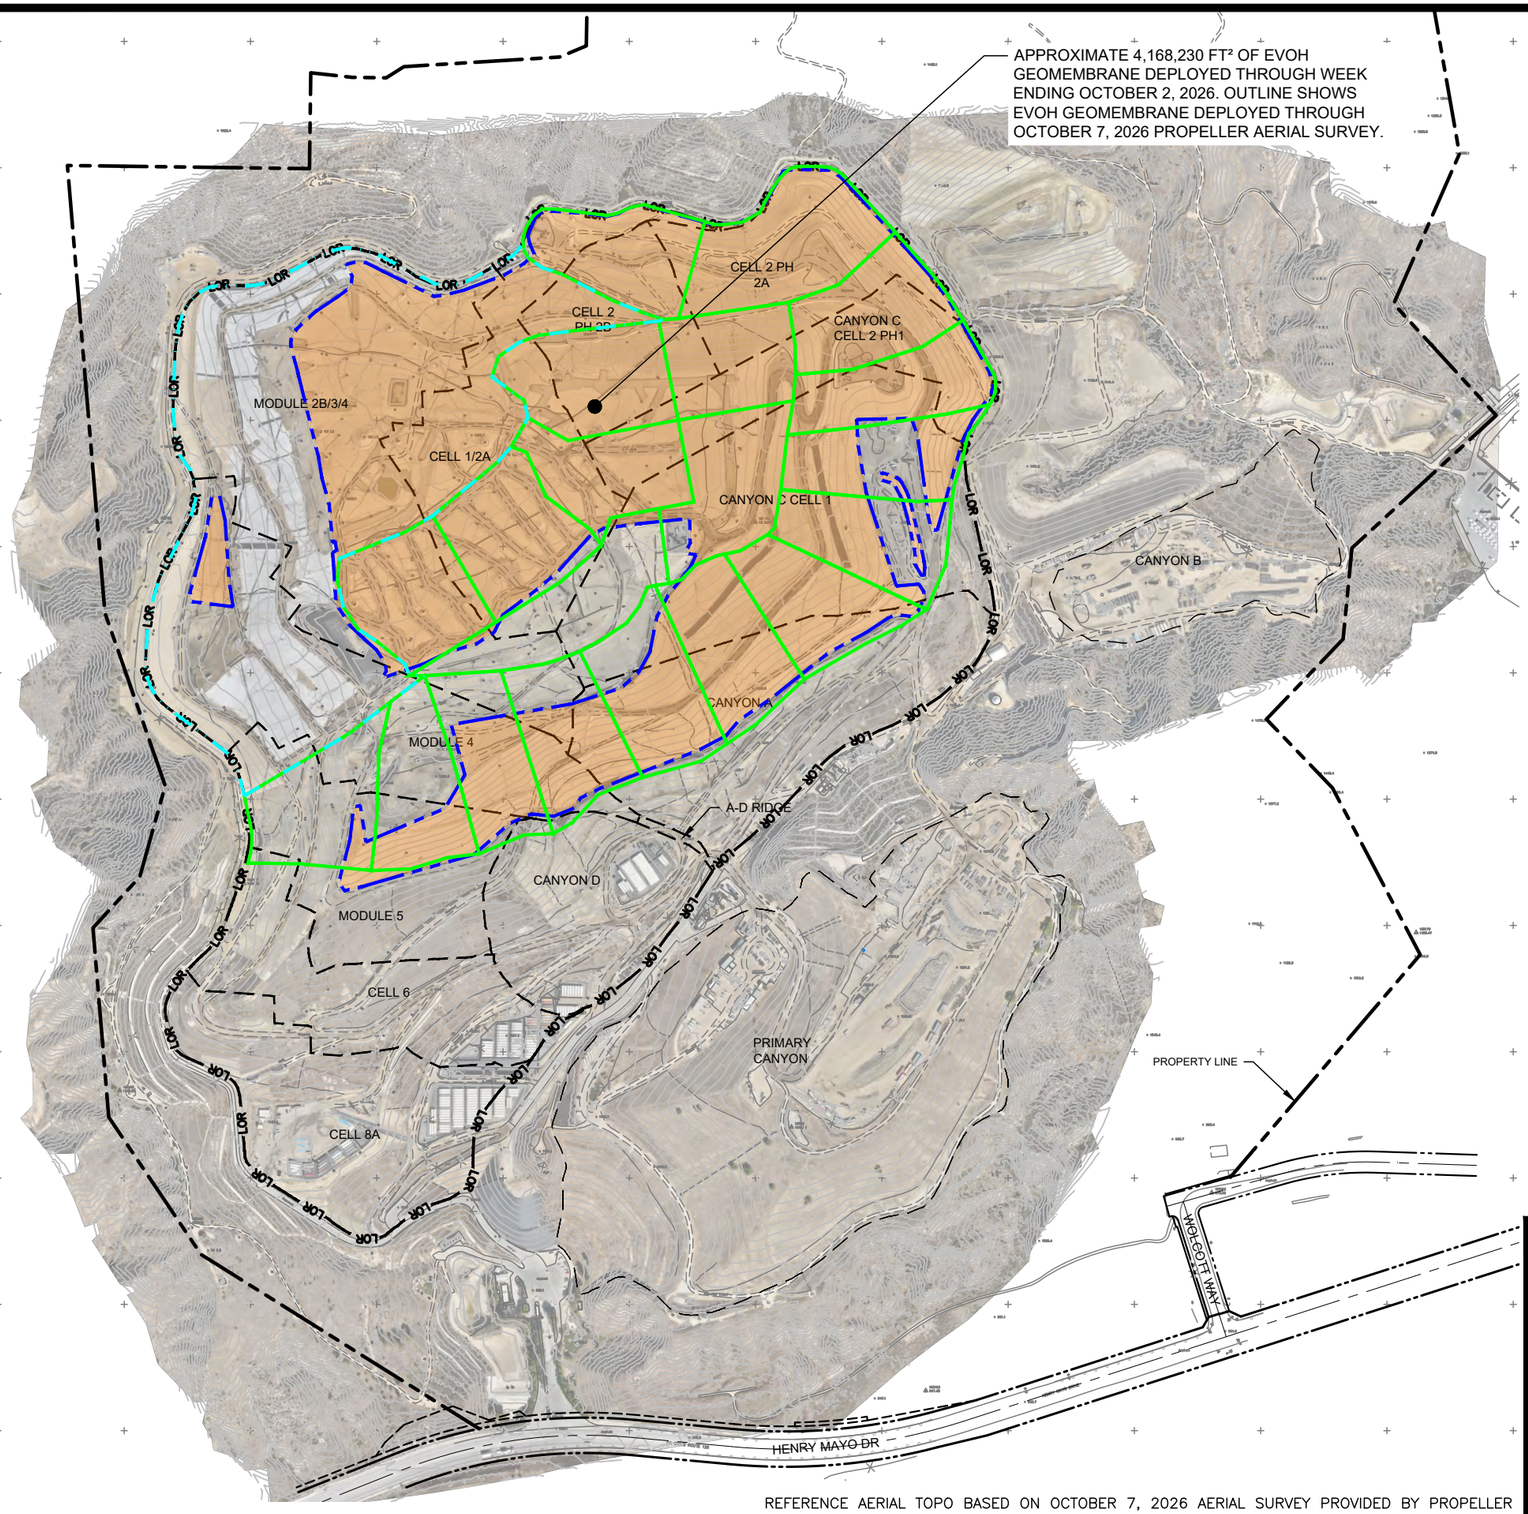

LEGEND:

- PROPERTY LINE
- LOR LOR — APPROXIMATE LIMIT OF REFUSE
- CELL LIMIT
- EXISTING GEOMEMBRANE DEPLOYMENT AREA
- INITAL SUPPLEMENTAL GEOMEMBRANE DEPLOYMENT AREA
- SUBSEQUENT SUPPLEMENTAL GEOMEMBRANE AREA

NOTE:
1. EXISTING GEOMEMBRANE DEPLOYMENT AREA IS APPROXIMATELY 48.3 ACRES.
2. EXISTING GEOMEMBRANE IS 30-MIL HDPE, EXCEPT FOR 1.3 ACRES OF 40-MIL HDPE.
3. EACH PROPOSED DEPLOYMENT AREA IS APPROXIMATELY 5 ACRES.
4. NEW GEOMEMBRANE WILL BE 60-MIL HDPE WITH AN INTERNAL CORE EVOH RESIN BARRIER.

N

600' 0' 300' 600'

SCALE: 1" = 600'

REFERENCE AERIAL TOPO BASED ON OCTOBER 7, 2026 AERIAL SURVEY PROVIDED BY PROPELLER

FIGURE 1

APPROXIMATE LIMITS OF DEPLOYED EVOH GEOMEMBRANE

CHIQUITA CANYON LANDFILL CASTAIC, CA

Geo-Logic ASSOCIATES

DRAWN BY: LP/RM	DATE: OCTOBER 2026	JOB NO.: RM22.1077

P:\SITES\CHIQUITA CYN LF\MONITORING SUMMARY\FIGURES-WEEKLY\RM22.1077-CCL-EVOH-FIG 1-(2026-10-09).DWG October 9, 2026 - 9:50 AM BY: GLA-USER