De:	Huber, Rachelle <RHuber@scsengineers.com>
Enviado:	Viernes 16 de octubre de 2026 5:57 PM
Para:	"ndickel@aqmd.gov"; Christina Ojeda; "Baitong Chen"
Cc:	Medina, Steven; Bill Haley; Viswanathan, Srividhya; Jones, Art; Mark.Adams; Dylan Smith; matthew.breuer@wasteconnections.com; Sarah Phillips; Kim, Jenny
Asunto:	Orden de Depuración Estipulada del Caso No. 6177-4 - Actualización sobre la Perforación del Pozo
Adjuntos:	2026-10-16_CCLF_GCCS Expan Weekly Well Install Notification Map_v0.0.pdf

Según la Condición 15(c) de la Orden Estipulada, a continuación, se encuentra el resumen actualizado de la construcción para el Proyecto del Plan Maestro de Ampliación de GCCS 2026 del Vertedero de Chiquita Canyon.


Del 12/10/2026 al 16/10/2026, Chiquita completó la instalación de un (1) pozo de extracción vertical de LFG. Tres cantidad total de pozos verticales de extracción de LFG instalados desde el 6 de diciembre de 2023 (la fecha de inicio de la Expansión Maestra de GCCS) hasta hoy es de trescientos cuarenta y cuatro (344).

Los pozos programados para perforación durante la semana del 19/10/2026 al 23/10/2026 son los siguientes (sujeto a cambios):

Plataforma (Secuencia): CV-2660, CV-2656, CV-2654, CV-2649, CV-2648
Las ubicaciones de las instalaciones de los pozos programadas para perforar la semana que viene están sujetas a cambios debido a los tiempos de inactividad de la plataforma, a las condiciones climáticas y/o de seguridad. Se debe tener en cuenta que todos los pozos programados para ser perforados la semana que viene son instalaciones nuevas; no hay nuevas perforaciones previstas.

Atentamente,

Rachelle Huber
Gerente de Proyectos
rhuber@scsengineers.com
O: 562-356-1068
C: 925-789-5710
4683 Chabot Drive, Suite 200
Pleasanton, CA 94588

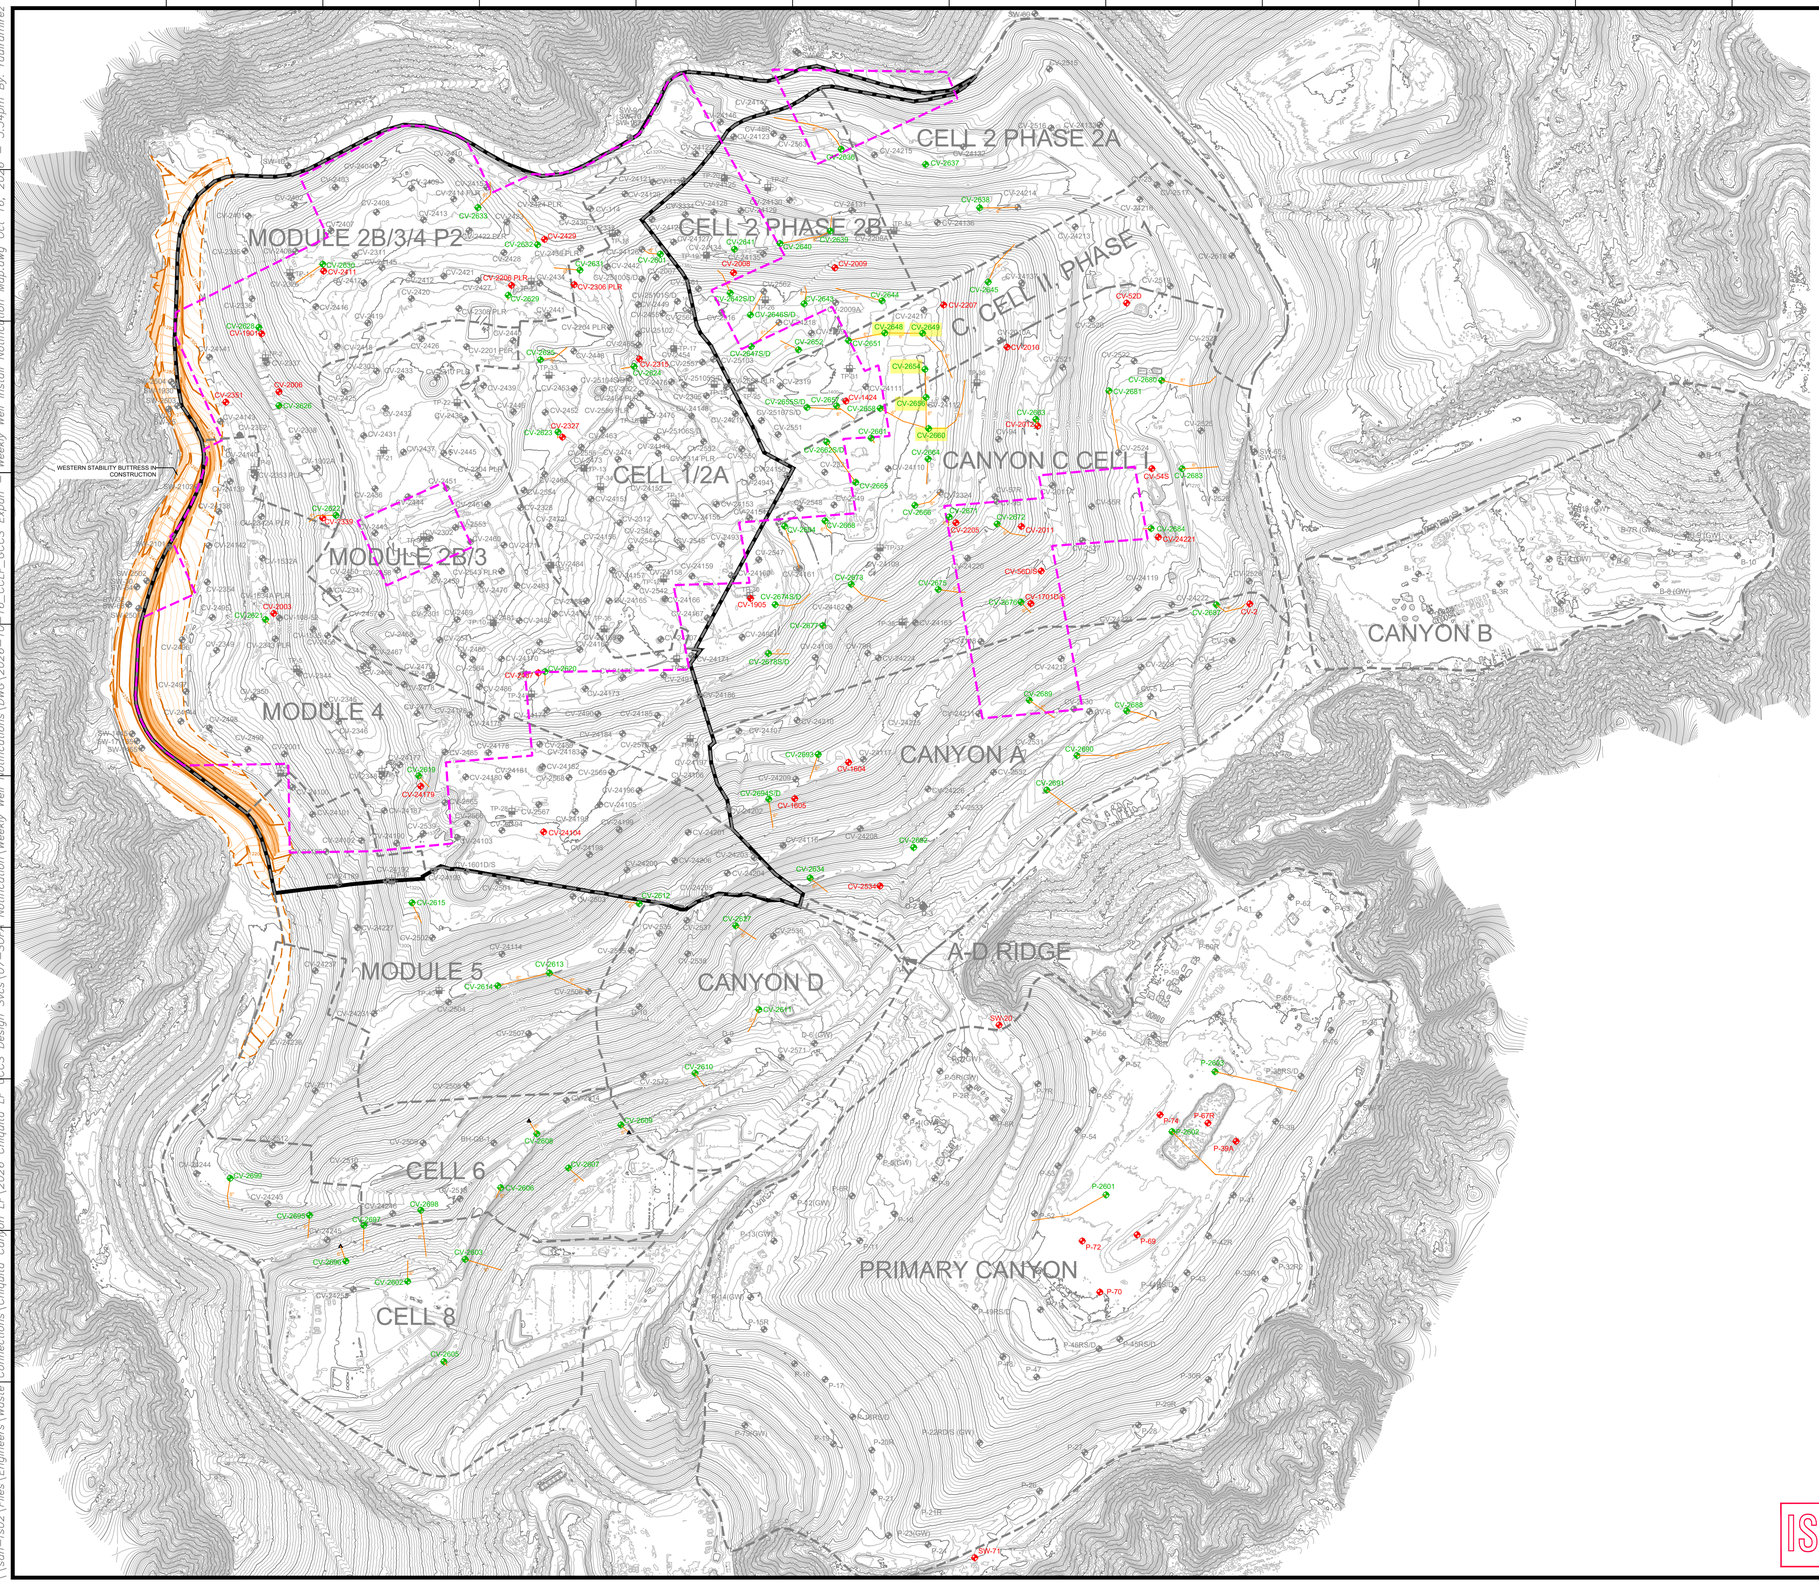

N

GRAPHIC SCALE

220 110 0 220 440 660

SCALE: 1"=220'

LEGEND

- 1150 — EXISTING TOPOGRAPHIC CONTOUR
- EXISTING CELL LIMITS (APPROXIMATE)
- REACTION MITIGATION AREA BOUNDARY - CONDITION 9A
- REACTION MITIGATION AREA BOUNDARY (APPROXIMATE)
- 2026 WEST SLOPE BUTTRESS FILL LIMITS(3)
- 1150 — 2026 WEST SLOPE LOWER AND UPPER BUTTRESS FILL MAJOR 10-FT CONTOUR(3)
- 2026 WEST SLOPE LOWER AND UPPER BUTTRESS FILL MINOR 2-FT CONTOUR(3)
- CV-XX — EXISTING LFG VERTICAL EXTRACTION WELL
- CV-XX PLR — EXISTING LFG VERTICAL EXTRACTION WELL - PRESSURIZED LEACHATE RELEASE
- BH-GB — EXISTING GABION LFG COLLECTOR WELL
- H/TC/SC-XX — EXISTING HORIZONTAL, TRENCH, SLOPE, OR COLLECTOR WELL
- TP-XX — EXISTING TEMPERATURE PROBE
- EXISTING LFG ISOLATION VALVE
- EXISTING LFG PIPE END CAP
- EXISTING LFG BLIND FLANGE
- PROPOSED LFG LATERAL 6" PIPING
- CV-XX — PROPOSED LFG VERTICAL EXTRACTION WELL
- CV-XX — PROPOSED LFG ABANDONMENT
- THE FOLLOWING HIGHLIGHTED WELLS ARE SCHEDULED FOR INSTALLATION:
  - CV-2660
  - CV-2656
  - CV-2654
  - CV-2648
  - CV-2649

GENERAL DRAWING NOTES:

1. EXISTING GCCS SHOWN IS DATED OCTOBER 7, 2026
2. EXISTING TOPOGRAPHIC SURVEY INFORMATION SHOWN WAS PROVIDED BY PROPELLER, DATED OCTOBER 7, 2026.
3. NORTH ARROW SHOWN HERE IS REFERENCE TO THE CALIFORNIA STATE PLANE ZONE V COORDINATE SYSTEM, NAD 83.
4. PROPOSED WEST SLOPE LOWER AND UPPER BUTTRESS FILL INFORMATION FROM CAD FILE "ChiquitaCanyon_WestSlopeMitigation_Lower and Upper Buttress." FILL PLAN PROVIDED BY CIVIL & ENVIRONMENTAL CONSULTANTS (CEC), INC.
5. APPROXIMATE REACTION MITIGATION AREA BOUNDARY DATED OCTOBER 10, 2026, BASED ON SEPTEMBER WELLFIELD DATA, PER SOFA CONDITION 8(m) AS DEFINED IN 9A.

ISSUED FOR CONSTRUCTION

NO.	REVISION	DATE

SHEET TITLE: PROPOSED OVERALL GCCS SITE PLAN

PROJECT TITLE: 2026 GCCS EXPANSION DESIGN PROJECT CHIQUITA CANYON LANDFILL CASTAIC, CALIFORNIA

CLIENT: CHIQUITA CANYON LANDFILL CASTAIC, CALIFORNIA

SCS ENGINEERS
ENVIRONMENTAL CONSULTANTS
3939 MUSICK, IRVINE, CA 92612
SUITE 300
LONG BEACH, CA 90808
PH: (562) 426-9544

PROJ. NO. 01204123.45 | DWN. BY: RR | ACAD FILE: F:\ENGINEERS | APP. BY: RNH | CHK. BY: RNH | DSN. BY: SRM / RNH

DATE: 10/16/2026

SCALE: AS SHOWN

SHEET: 3

\\scs-fs02\Files\Engineers\Waste Connections\Chiquita Canyon LF\2026 Chiquita LF GCCS Design Svcs\07-SOFA Notification\Weekly Well Install Notification Map.dwg Oct 16, 2026 - 3:34pm By: raulramirez
16_CCLF_GCCS Expan - 10