De: WILLIAM.HALEY@WasteConnections.com
Enviado: viernes 23 de octubre de 2026 4:10 PM
Para: Karen Gork
Cc: Todd.Thalhamer@Calrecycle.ca.gov; LFrias@ph.lacounty.gov; NQuick@ph.lacounty.gov; RRagland@ph.lacounty.gov; BMcphillips@counsel.lacounty.gov; Wes.Mindermann@CalRecycle.ca.gov; mark.debie@calrecycle.ca.gov; mark.debie@calrecycle.ca.gov; emorofuji@ph.lacounty.gov; btway@ph.lacounty.gov; Relon.MarkAnthony@epa.gov; Holybee.Tyler@epa.gov; Friedli.Laura@epa.gov; John Perkey; Sarah Phillips; Gregory.Shaffer@dtsc.ca.gov; Natasha.DiPietro@dtsc.ca.gov; Gregory.Gentile@dtsc.ca.gov; Dylan Smith
Asunto: Re: Vertedero de Chiquita Canyon – Cubierta Geosintética – Medida de Mitigación 4.1
Adjuntos: RM22.1077-CCL-EVOH-FIG 1-(2026-10-22)-FIG 1.pdf; Milestone 2B Chiquita Canyon LF Isopach_Sep.2026.pdf; 2026-10-16_CCLF Reaction Area - Reactive Wells - September_V1.0.pdf

A continuación, se encuentra la actualización semanal de Chiquita sobre el estado de la instalación de la cubierta de geomembrana de EVOH/HDPE de 60 milésimas de pulgada en el Vertedero de Chiquita Canyon, conforme a la Medida de Mitigación 4.1 de la Orden de Cumplimiento de la LEA emitida el 1 de mayo de 2025.


Al 16 de octubre de 2026, D&E, en nombre de Chiquita, ha instalado aproximadamente 4,411,630 pies cuadrados de cubierta de geomembrana de EVOH/HDPE de 60 milésimas de pulgada marrón. De este total, se desplegaron aproximadamente 845,796 pies cuadrados sobre la geomembrana existente de 30 milésimas de pulgada para aumentar su efectividad. La obra realizada la semana del 12 de octubre incluyó amplias reparaciones y el detallado de los paneles existentes, incluidos la fabricación de botas, la colocación de parches, la soldadura por extrusión, la recostura y la colocación de bolsas de arena, según la necesidad. El trabajo continuó durante la semana del 19 de octubre de 2026. Chiquita ha incluido el resumen a continuación con las cantidades totales de Revestimiento:

	Se Instaló un Revestimiento de EVOH Nuevo	Revestimiento de EVOH Instalado sobre revestimiento de 30 milésimas de pulgada existente	Revestimiento de 30 milésimas de pulgada existente	Se Instaló el Total del Revestimiento
7/8/2026	2,629,969	736,689	1,564,950	4,931,608
14/8/2026	2,752,615	736,689	1,564,950	5,054,254
21/8/2026	2,860,533	736,689	1,564,950	5,162,172
28/8/2026	2,972,601	736,689	1,564,950	5,274,240
4/9/2026	3,070,743	736,689	1,564,950	5,372,382
11/9/2026	3,130,545	736,689	1,564,950	5,432,184
18/9/2026	3,232,497	736,689	1,564,950	5,534,136
25/9/2026	3,411,786	736,689	1,564,950	5,713,425
2/10/2026	3,411,786	756,444	1,545,195	5,713,425
9/10/2026	3,499,254	796,226	1,545,195	5,840,675
16/10/2026	3,565,834	845,796	1,545,195	5,907,255

El mapa del sitio adjunto muestra la extensión aproximada de la cubierta de geomembrana instalada al miércoles 14 de octubre de 2026, como también la cubierta de geomembrana descrita en el anteproyecto del plan de trabajo revisado para la extensión del área de la cubierta de geomembrana presentado a la LEA, a la US EPA y al DTSC el 13 de marzo de 2026. También se adjuntan a esta entrega el mapa isopáquico mensual de septiembre de 2026 y una figura que identifica los pozos que muestran indicios de reacción al 16 de octubre de 2026 en base a la Zona de Mitigación de Reacciones de junio. Debido a limitaciones técnicas, actualmente no podemos crear una figura que incluya todos estos datos.

Gracias,

Bill Haley, PE
Ingeniero de Proyectos Sénior
O: 661.257.3655 | C: 661.964.5821
Vertedero de Chiquita Canyon | 29201 Henry Mayo Dr. | Castaic, CA 91384
Connect With the Future © *www.wasteconnections.com*

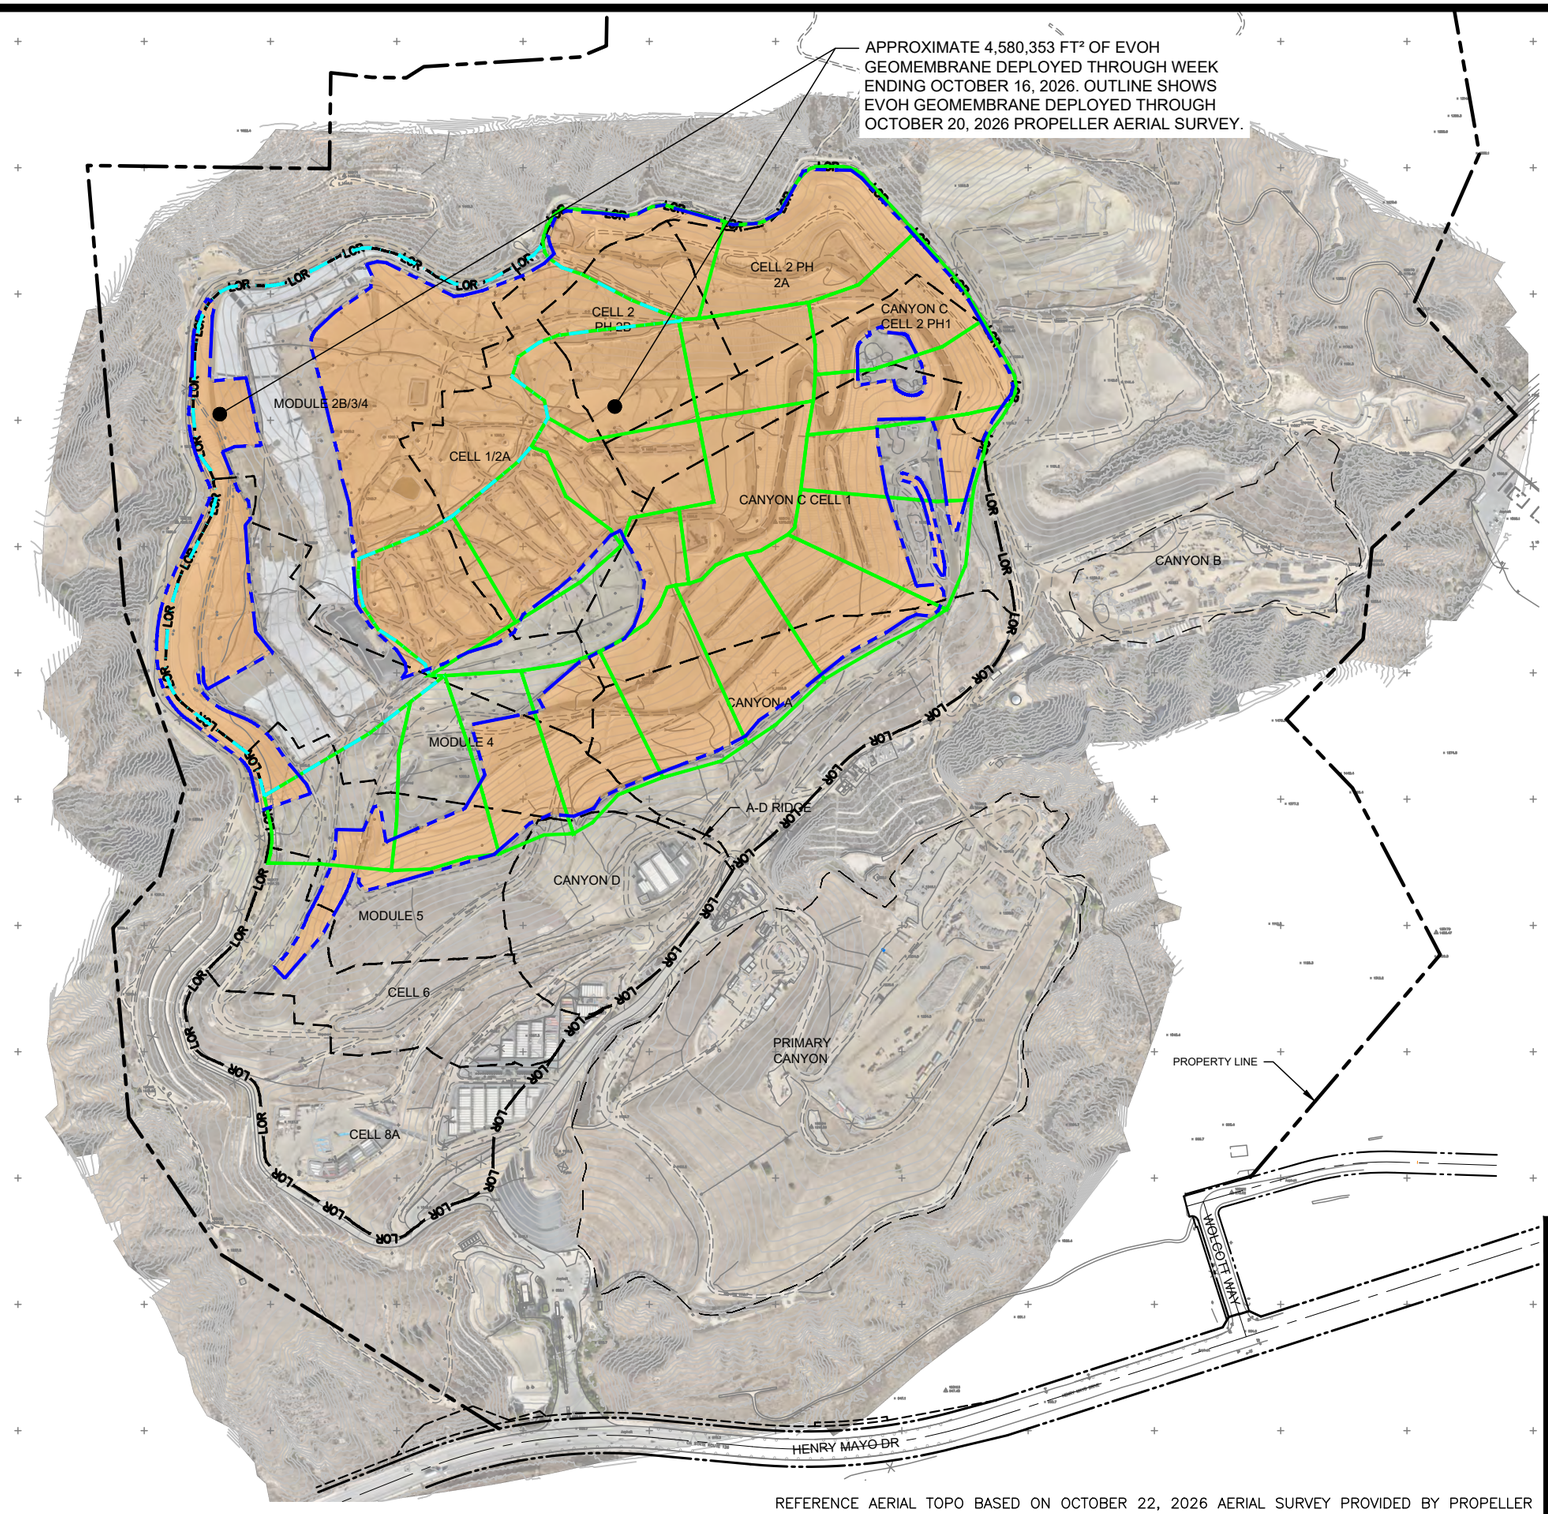

LEGEND:

- PROPERTY LINE
- APPROXIMATE LIMIT OF REFUSE
- CELL LIMIT
- EXISTING GEOMEMBRANE DEPLOYMENT AREA
- INITAL SUPPLEMENTAL GEOMEMBRANE DEPLOYMENT AREA
- SUBSEQUENT SUPPLEMENTAL GEOMEMBRANE AREA

NOTE:
1. EXISTING GEOMEMBRANE DEPLOYMENT AREA IS APPROXIMATELY 48.3 ACRES.
2. EXISTING GEOMEMBRANE IS 30-MIL HDPE, EXCEPT FOR 1.3 ACRES OF 40-MIL HDPE.
3. EACH PROPOSED DEPLOYMENT AREA IS APPROXIMATELY 5 ACRES.
4. NEW GEOMEMBRANE WILL BE 60-MIL HDPE WITH AN INTERNAL CORE EVOH RESIN BARRIER.

600' 0' 300' 600'

SCALE: 1" = 600'

REFERENCE AERIAL TOPO BASED ON OCTOBER 22, 2026 AERIAL SURVEY PROVIDED BY PROPELLER

FIGURE 1

APPROXIMATE LIMITS OF DEPLOYED EVOH GEOMEMBRANE


CHIQUITA CANYON LANDFILL CASTAIC, CA


Geo-Logic ASSOCIATES

DRAWN BY: LP/RM	DATE: OCTOBER 2026	JOB NO.: RM22.1077


P:\SITES\CHIQUITA CYN LF\MONITORING SUMMARY\FIGURES-WEEKLY\RM22.1077-CCL-EVOH-FIG 1-(2026-10-22).DWG October 22, 2026 - 1:52 PM BY: GLA-USER

Chiquita Canyon Landfill -Isopach

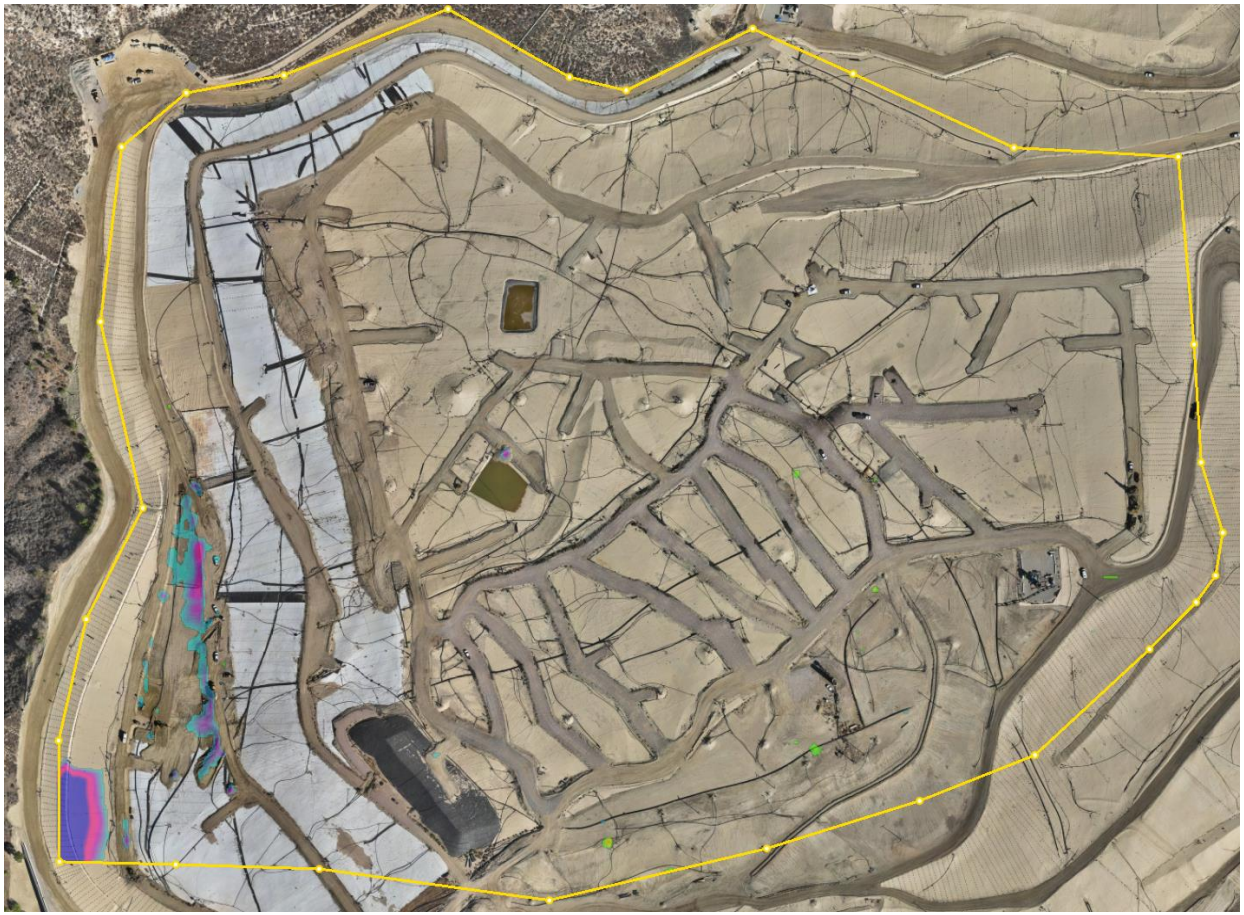

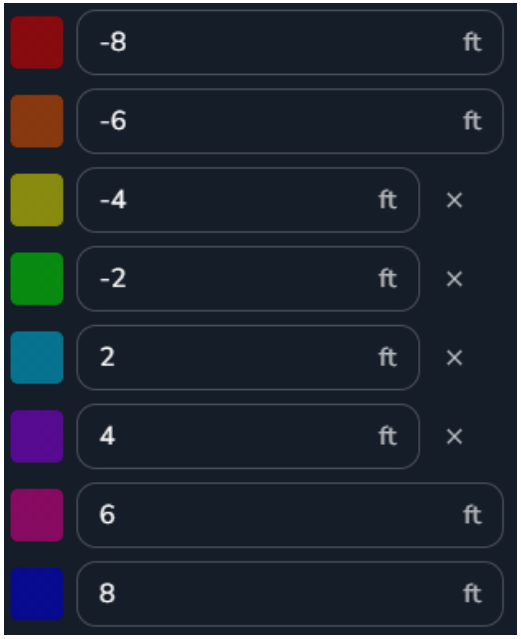

Sep 30, 2026 Survey Image. Sep 2, 2026 vs Sep 30, 2026

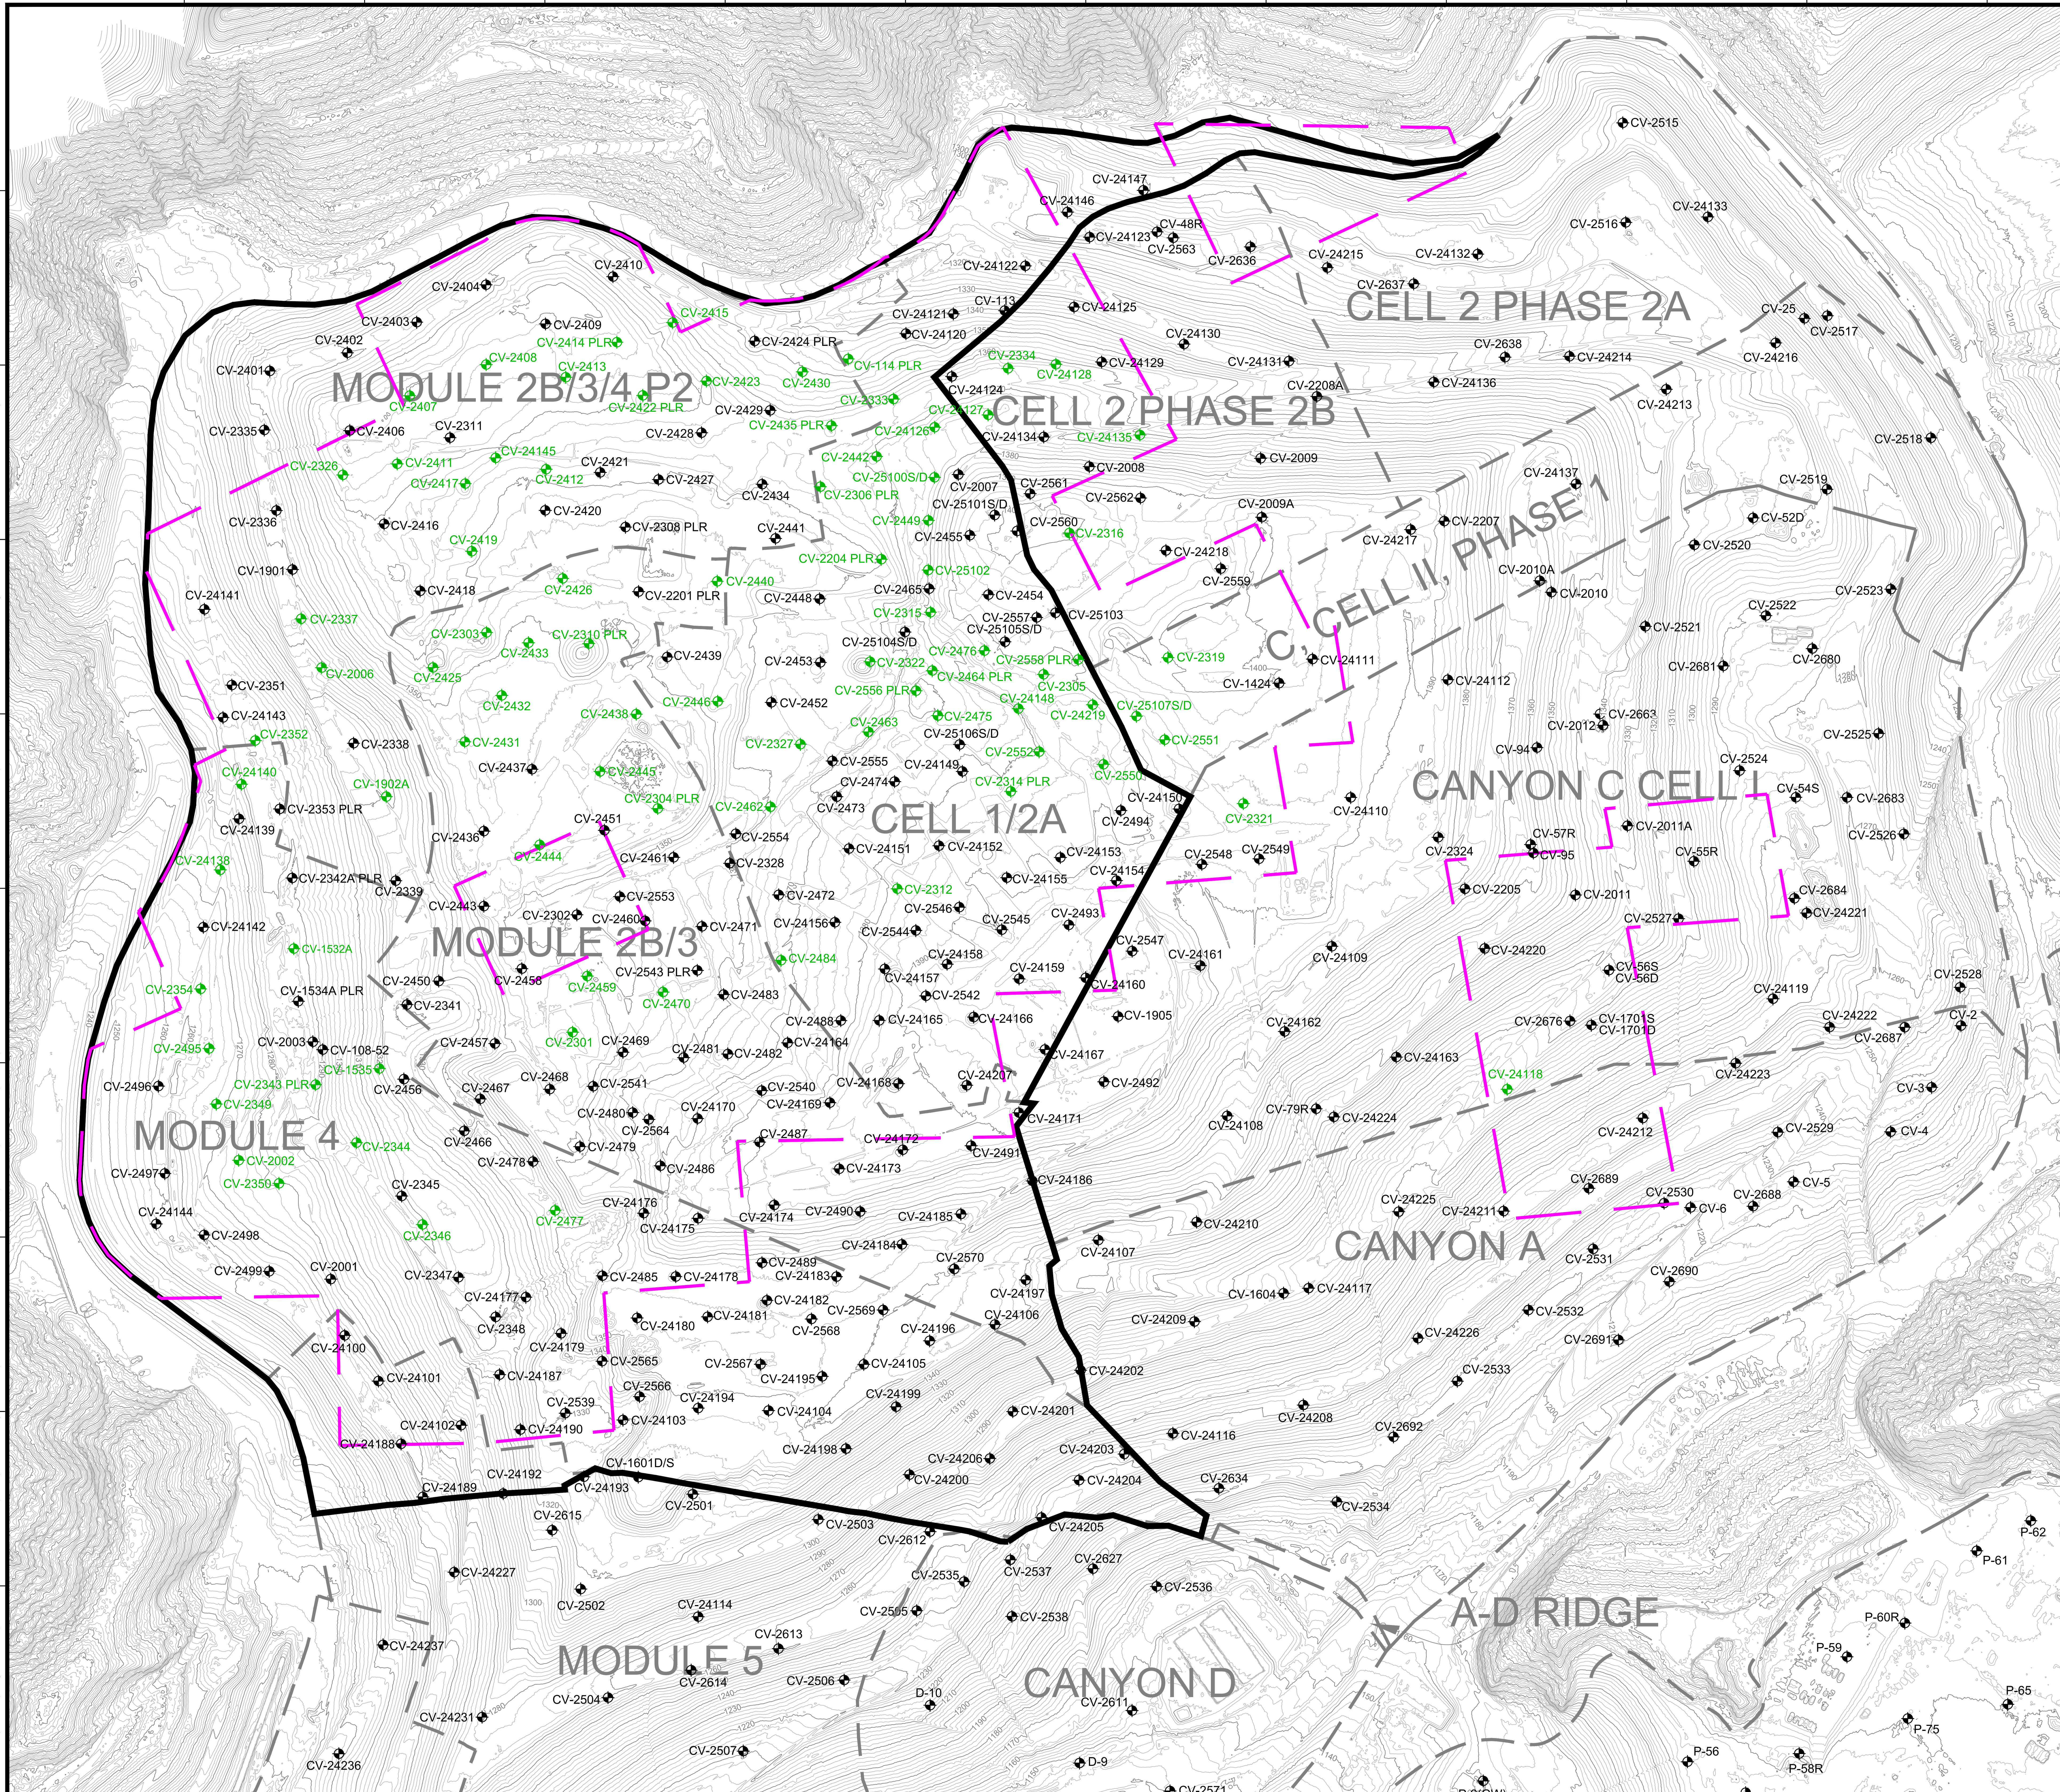

N

GRAPHIC SCALE

150 75 0 150 300 450

SCALE: 1"=150'

LEGEND

1150	EXISTING TOPOGRAPHIC CONTOUR
	EXISTING CELL LIMITS (APPROXIMATE)
	PROPOSED REACTION MITIGATION AREA BOUNDARY
	REACTION MITIGATION AREA BOUNDARY - CONDITION 9A
CV-XX	EXISTING VERTICAL WELLS
CV-XX PLR	EXISTING VERTICAL WELL - PRESSURIZED LEACHATE RELEASE
CV-XX	EXISTING VERTICAL WELLS - REACTIVE

GENERAL DRAWING NOTES:

1. EXISTING GCCS AS-BUILT DATED SEPTEMBER 30, 2026.
2. APPROXIMATED REACTION MITIGATION AREA BOUNDARY DATED OCTOBER 9, 2026, BASED ON SEPTEMBER DATA, PER SOFA CONDITION 8(m) AS DEFINED IN 9B.
3. EXISTING TOPOGRAPHIC SURVEY INFORMATION SHOWN WAS PROVIDED BY PROPELLER AERIAL PHOTOGRAPHY DATED SEPTEMBER 30, 2026.
4. NORTH ARROW SHOWN HERE IS REFERENCE TO THE CALIFORNIA STATE PLANE ZONE V COORDINATE SYSTEM, NAD 83.
5. LOCATIONS OF EXISTING FEATURES ARE APPROXIMATE AND SHOULD BE USED FOR INFORMATIONAL PURPOSES ONLY. ACTUAL FIELD CONDITIONS MAY VARY AND ARE SUBJECT TO CHANGE BASED ON TOPOGRAPHIC OR SITE-SPECIFIC CONDITIONS.

NO.	REVISION	DATE

SHEET TITLE: REACTION AREA MAP - SEPTEMBER 2026 REACTIVE VERTICAL EXTRACTION WELLS

PROJECT TITLE: CHIQUITA CANYON LANDFILL CASTAIC, CALIFORNIA

CLIENT: CHIQUITA CANYON LANDFILL CASTAIC, CALIFORNIA

SCS ENGINEERS
ENVIRONMENTAL CONSULTANTS
3900 KILROY AIRPORT WAY, SUITE 300
LONG BEACH, CA 90806
PH. (562) 426-9544

PROJ. NO. 01204123.45	DSN. BY: ISR
DWN. BY: ISR	CHK. BY: RNH/SRM
ACAD FILE: F:/ENGINEERS	APP. BY: RNH

DATE: 10/16/2026

SCALE: AS SHOWN

SHEET: 1

\\san-fs02\Files\Engineers\Waste Connections\Chiquita Canyon LF\2026 Reaction Area Maps\09-September\DWG\2026-10-15_WC_CCLF Reaction Area _September Reactive Wells.dwg Oct 16, 2026 - 8:42am By: istarosa