From:	Medina, Steven <SMedina@scsengineers.com>
Sent:	Friday, November 6, 2026 1:33 PM
To:	Baitong Chen; Nathaniel Dickel; Christina Ojeda
Cc:	Huber, Rachelle; Chris Fear; Viswanathan, Srividhya; Mark.Adams; Dylan Smith; Sarah Phillips; Bill Haley
Subject:	No. 6177-4 Stipulated Order for Abatement - Weekly Pump Installation and Operation Update
Attachments:	2026-11-06_CCLF_Existing De-Watering Well with Pump Map_V1.0.pdf

Hello All,

In accordance with Condition 65 of the Modified Stipulated Order, below is the summary of the installation and operation of dewatering pumps for the Chiquita Canyon Landfill. This information is subject to change based on further review and verification.

During 10/30/2026 to 11/05/2026, Chiquita completed the installation of, and began operating during the day, eleven (11) new pumps in a vertical LFG extraction well for a total of two-hundred-and-four (204) pumps operating in vertical LFG extraction wells. Additionally, twelve (12) pumps were taken offline last week, and eleven (11) new pumps became operational, leading to a net decrease of one (1) pump. Please note that Chiquita has additional pumps in operation in perimeter sumps that are not included in this count.


During 11/06/2026 to 11/12/2026, given the number of dewatering pumps installed to date, and the maintenance associated with those pumps, Chiquita plans to install and begin operating five (5) additional pumps in vertical LFG extraction wells in locations along the north and south slope of the reaction area.

Regards,

SCS ENGINEERS

STEVEN Medina, E.I.T.
Project Professional
smedina@scsengineers.com
O: 858-583-7746
M: 858-204-4342
3900 Kilroy Airport Way, Suite #300
Long Beach, CA 90806

GENERAL DRAWING NOTES:
1. EXISTING GCCS VERTICAL WELL AS-BUILT DATED NOVEMBER 06, 2026.
2. EXISTING TOPOGRAPHIC SURVEY INFORMATION SHOWN WAS PROVIDED BY PROPELLER AERIAL PHOTOGRAPHY DATED OCTOBER 28, 2026.
3. NORTH ARROW SHOWN IN REFERENCE TO CALIFORNIA STATE PLANE ZONE V COORDINATE SYSTEM, NAD 83.
4. APPROXIMATE REACTION MITIGATION AREA BOUNDARY DATED OCTOBER 10, 2026, BASED ON SEPTEMBER WELLFIELD DATA, PER SOFA CONDITION 8(m) AS DEFINED IN 9A.
5. THE LOCATION OF ANY EXISTING GCCS COMPONENTS AND OTHER FEATURES ARE APPROXIMATE AND SHOULD BE USED FOR INFORMATION PURPOSES ONLY.

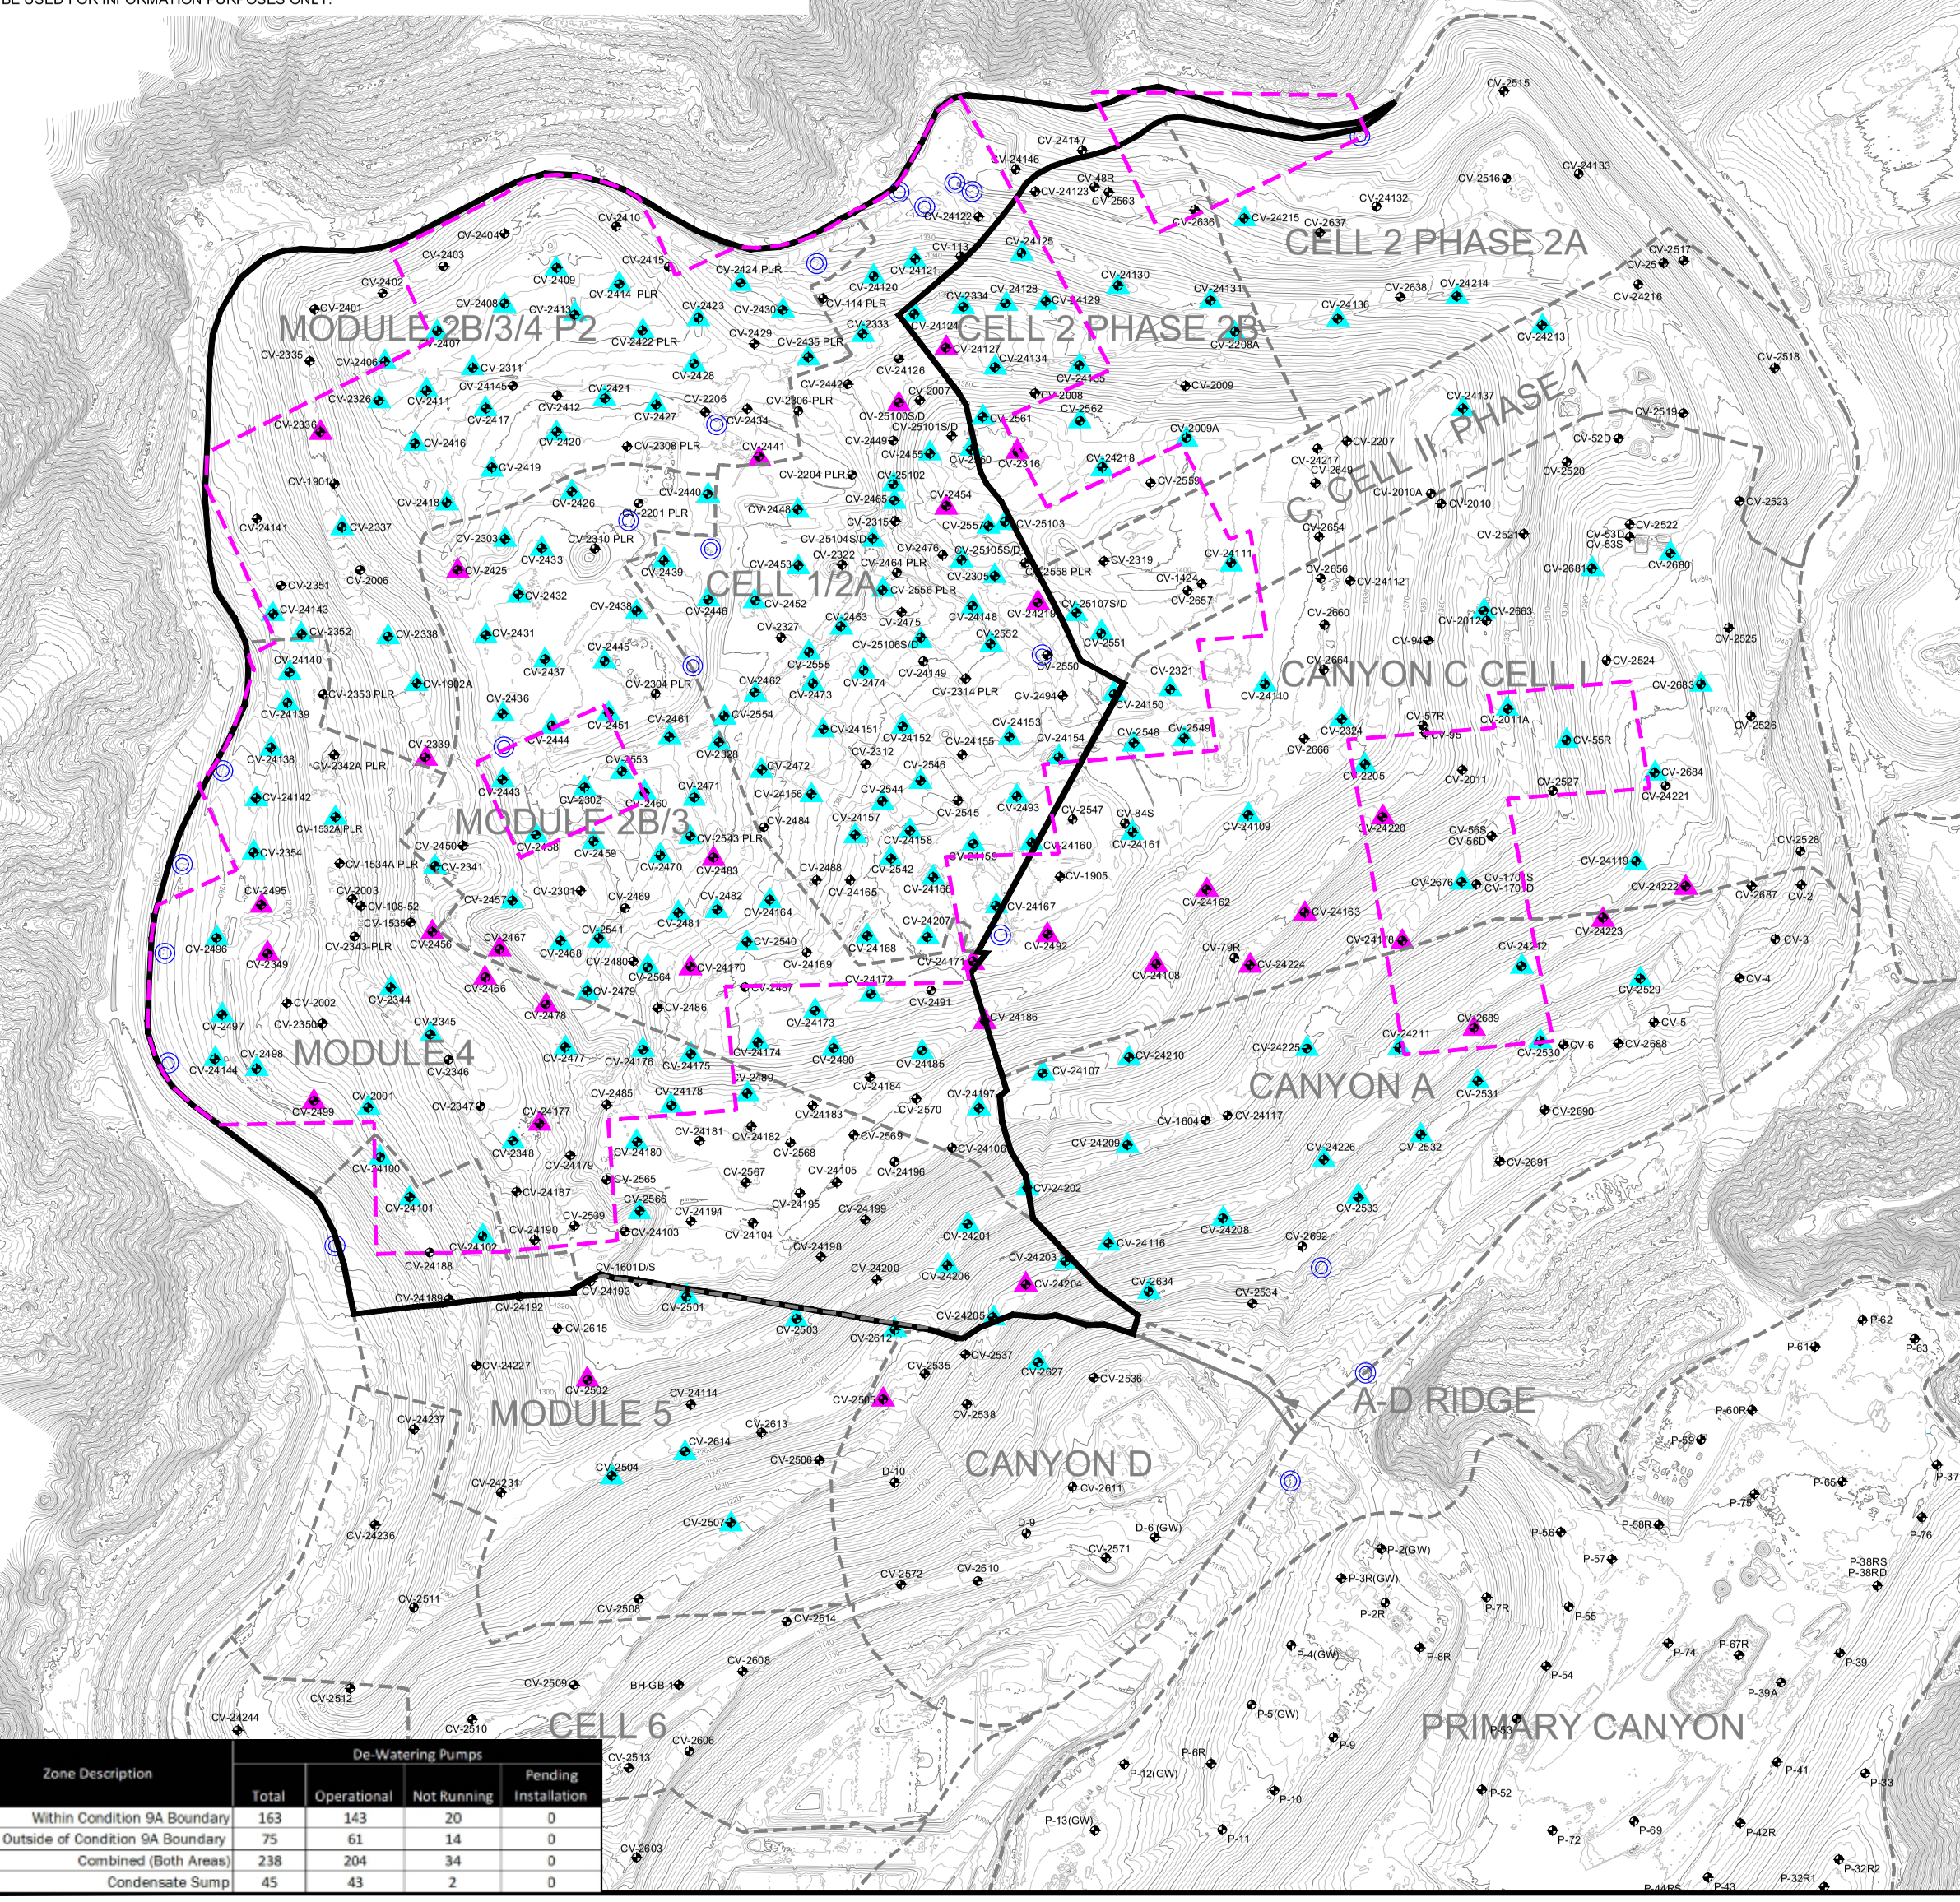

Zone Description	De-Watering Pumps			
	Total	Operational	Not Running	Pending Installation
Within Condition 9A Boundary	163	143	20	0
Outside of Condition 9A Boundary	75	61	14	0
Combined (Both Areas)	238	204	34	0
Condensate Sump	45	43	2	0

De-Watering Well Pumps Currently Running

#	Well I.D.	Install Date	#	Well I.D.	Install Date
1	CV-2001	3/2/2025	105	CV-2530	10/3/2025
2	CV-2205	3/6/2025	106	CV-2496	10/4/2025
3	CV-2209A	3/9/2025	107	CV-2497	10/5/2025
4	CV-2302	3/10/2025	108	CV-55R	10/7/2025
5	CV-2324	3/15/2025	107	CV-24139	10/9/2025
6	CV-2326	3/20/2025	108	CV-24140	10/10/2025
7	CV-2328	3/22/2025	109	CV-24128	10/13/2025
8	CV-2337	3/26/2025	110	CV-24213	10/15/2025
9	CV-2338	3/27/2025	111	CV-2532	10/17/2025
10	CV-2341	3/29/2025	112	CV-2533	10/17/2025
11	CV-2344	3/31/2025	113	CV-2529	10/18/2025
12	CV-2345	4/1/2025	114	CV-2433	10/28/2025
13	CV-2348	4/4/2025	115	CV-2551	10/30/2025
14	CV-2394	4/9/2025	116	CV-1903A	11/21/2025
15	CV-2406	4/10/2025	117	CV-2011A	11/24/2025
16	CV-2409	4/13/2025	118	CV-24015	11/24/2025
17	CV-2411	4/14/2025	119	CV-24164	12/11/2025
18	CV-2413	4/16/2025	120	CV-2461	12/17/2025
19	CV-2416	4/19/2025	121	CV-24156	12/17/2025
20	CV-2417	4/20/2025	122	CV-24157	12/18/2025
21	CV-2418	4/21/2025	123	CV-24158	12/19/2025
22	CV-2423	4/25/2025	124	CV-24152	12/22/2025
23	CV-2424-PLR	4/26/2025	125	CV-24153	1/5/2026
24	CV-2427	4/29/2025	126	CV-2362	1/26/2026
25	CV-2430	5/1/2025	127	CV-2468	2/3/2026
26	CV-2432	5/3/2025	128	CV-24201	3/26/2026
27	CV-2436	5/6/2025	129	CV-24178	3/30/2026
28	CV-2437	5/7/2025	130	CV-2555	4/1/2026
29	CV-2438	5/8/2025	131	CV-24176	4/3/2026
30	CV-2443	5/14/2025	132	CV-2422-PLR	4/6/2026
31	CV-2444	5/15/2025	133	CV-2321	4/9/2026
32	CV-2445	5/16/2025	134	CV-2531	4/29/2026
33	CV-2448	5/17/2025	135	CV-24142	5/4/2026
34	CV-2446	5/16/2025	136	CV-2303	6/5/2026
35	CV-2451	5/21/2025	137	CV-2474	6/16/2026
36	CV-2453	5/23/2025	138	CV-2477	6/16/2026
37	CV-2455	5/25/2025	139	CV-2553	6/17/2026
38	CV-2457	5/27/2025	140	CV-2482	6/18/2026
39	CV-2459	5/29/2025	141	CV-2544	6/18/2026
40	CV-2460	5/30/2025	142	CV-2546	6/18/2026
41	CV-2462	6/1/2025	143	CV-2540	6/23/2026
42	CV-2463	6/2/2025	144	CV-2548	6/25/2026
43	CV-2465	6/4/2025	145	CV-2414-PLR	7/3/2026
44	CV-2470	6/9/2025	146	CV-2407	7/7/2026
45	CV-2471	6/10/2025	147	CV-2452	7/7/2026
46	CV-2472	6/11/2025	148	CV-2009A	7/10/2026
47	CV-2473	6/12/2025	149	CV-2311	7/10/2026
48	CV-2479	6/16/2025	150	CV-25100D	7/14/2026
49	CV-2481	6/20/2025	151	CV-2543 PLR	7/16/2026
50	CV-2490	6/25/2025	152	CV-2501	7/17/2026
51	CV-2493	7/2/2025	153	CV-24151	7/21/2026
52	CV-2498	7/3/2025	154	CV-2564	7/21/2026
53	CV-24100	7/4/2025	155	CV-24102	7/28/2026
54	CV-24107	7/7/2025	156	CV-2507	8/3/2026
55	CV-24109	7/9/2025	157	CV-2560	8/3/2026
56	CV-24111	7/11/2025	158	CV-2556-PLR	8/6/2026
57	CV-24116	7/12/2025	159	CV-2562	8/7/2026
58	CV-24119	7/15/2025	160	CV-2488	8/10/2026
59	CV-24110	7/17/2025	161	CV-15534-PLR	8/12/2026
60	CV-24124	7/19/2025	162	CV-2503	8/12/2026
61	CV-24125	7/20/2025	163	CV-2541	8/13/2026
62	CV-24134	7/27/2025	164	CV-25104D	8/14/2026
63	CV-24135	7/28/2025	165	CV-2542	8/18/2026
64	CV-24136	7/29/2025	166	CV-2406	8/19/2026
65	CV-24137	7/30/2025	167	CV-2428	8/19/2026
66	CV-24138	7/31/2025	168	CV-2421	8/20/2026
67	CV-24143	8/3/2025	169	CV-2333	8/21/2026
68	CV-24144	8/4/2025	170	CV-24129	8/26/2026
69	CV-24150	8/7/2025	171	CV-24218	9/2/2026
70	CV-24120	8/8/2025	172	CV-2419	9/3/2026
71	CV-24154	8/10/2025	173	CV-25102	9/4/2026
72	CV-24159	8/10/2025	174	CV-2549	9/11/2026
73	CV-24160	8/15/2025	175	CV-2680	9/13/2026
74	CV-24160	8/16/2025	176	CV-24121	9/17/2026
75	CV-24161	8/17/2025	177	CV-24130	9/17/2026
76	CV-24166	8/22/2025	178	CV-25106D	9/17/2026
77	CV-24167	8/23/2025	179	CV-2567	9/18/2026
78	CV-24168	8/24/2025	180	CV-25103	9/21/2026
79	CV-24172	8/28/2025	181	CV-25105D	9/21/2026
80	CV-24173	8/30/2025	182	CV-2420	9/23/2026
81	CV-24174	8/30/2025	183	CV-24131	9/24/2026
82	CV-24175	8/31/2025	184	CV-2684	9/25/2026
83	CV-2489	9/4/2025	185	CV-2683	9/26/2026
84	CV-24146	9/4/2025	186	CV-2334	9/28/2026
85	CV-24165	9/4/2025	187	CV-2681	9/30/2026
86	CV-2305	9/8/2025	188	CV-2439	10/2/2026
87	CV-24197	9/6/2025	189	CV-2634	10/5/2026
88	CV-24202	9/10/2025	190	CV-2612	10/6/2026
89	CV-24203	9/11/2025	191	CV-24206	10/7/2026
90	CV-24205	9/13/2025	192	CV-25106S	10/7/2026
91	CV-2440	9/15/2025	193	CV-2627	10/8/2026
92	CV-24207	9/15/2025	194	CV-24101	10/13/2026
93	CV-24208	9/16/2025	195	CV-2561	10/13/2026
94	CV-24209	9/17/2025	196	CV-2562	10/15/2026
95	CV-2426	9/16/2025	197	CV-2435	10/18/2026
96	CV-2431	9/16/2025	198	CV-2663	10/26/2026
97	CV-24210	9/18/2025	199	CV-2676	10/27/2026
98	CV-24211	9/19/2025	200	CV-2504	10/28/2026
99	CV-24212	9/20/2025	201	CV-2554	10/29/2026
100	CV-24214	9/21/2025	202	CV-2614	10/29/2026
101	CV-24225	10/1/2025	203	CV-25107D	11/4/2026
102	CV-24226	10/2/2025	204	CV-2566	11/5/2026

N

GRAPHIC SCALE

200 100 0 200 400 600

SCALE: 1"=200'

LEGEND

Symbol	Description
1150	TOPOGRAPHIC CONTOUR
(gray dashed line)	EXISTING CELL LIMITS (APPROXIMATE)
(solid black line)	REACTION MITIGATION AREA BOUNDARY - CONDITION 9A
(magenta dashed line)	REACTION MITIGATION AREA BOUNDARY
CV-XX	EXISTING VERTICAL EXTRACTION WELL
CV-XX PLR	EXISTING VERTICAL EXTRACTION WELL - PRESSURIZED LEACHATE RELEASE
(double circle)	EXISTING CONDENSATE SUMP - WITH PUMP
(cyan triangle)	EXISTING DE-WATERING WELL - PUMP INSTALLED AND RUNNING
(magenta triangle)	EXISTING DE-WATERING WELL - PUMP INSTALLED, NOT RUNNING

De-Watering Well Pumps Currently Installed NOT RUNNING

#	Well I.D.	#	Well I.D.
1	CV-2316	18	CV-24223
2	CV-2336	19	CV-24224
3	CV-2339	20	CV-2425
4	CV-2349	21	CV-2441
5	CV-24108	22	CV-2454
6	CV-24118	23	CV-2456
7	CV-24127	24	CV-2466
8	CV-24162	25	CV-2467
9	CV-24163	26	CV-2478
10	CV-24170	27	CV-2483
11	CV-24171	28	CV-2492
12	CV-24177	29	CV-2495
13	CV-24186	30	CV-2499
14	CV-24204	31	CV-2502
15	CV-24219	32	CV-2505
16	CV-24220	33	CV-25100S
17	CV-24222	34	CV-2689

NO.	REVISION	DATE

SHEET TITLE: EXISTING DE-WATERING WELLS

PROJECT TITLE: CHIQUITA CANYON LANDFILL CASTAIC, CALIFORNIA

CLIENT: CHIQUITA CANYON LANDFILL CASTAIC, CALIFORNIA

SCS ENGINEERS
ENVIRONMENTAL CONSULTANTS
3900 KILROY AIRPORT WAY, SUITE 300
LONG BEACH, CA 90806
PH. (562) 426-9544

PROJ. NO.	DWN. BY:	ACAD FILE:
01204123.45	APB	N:/CAD/ASBUILT-MASTERS
DSN. BY:	CHK. BY:	APP. BY:
-	SRM	SRM

DATE: 11/06/2026

SCALE: AS SHOWN

SHEET: 1