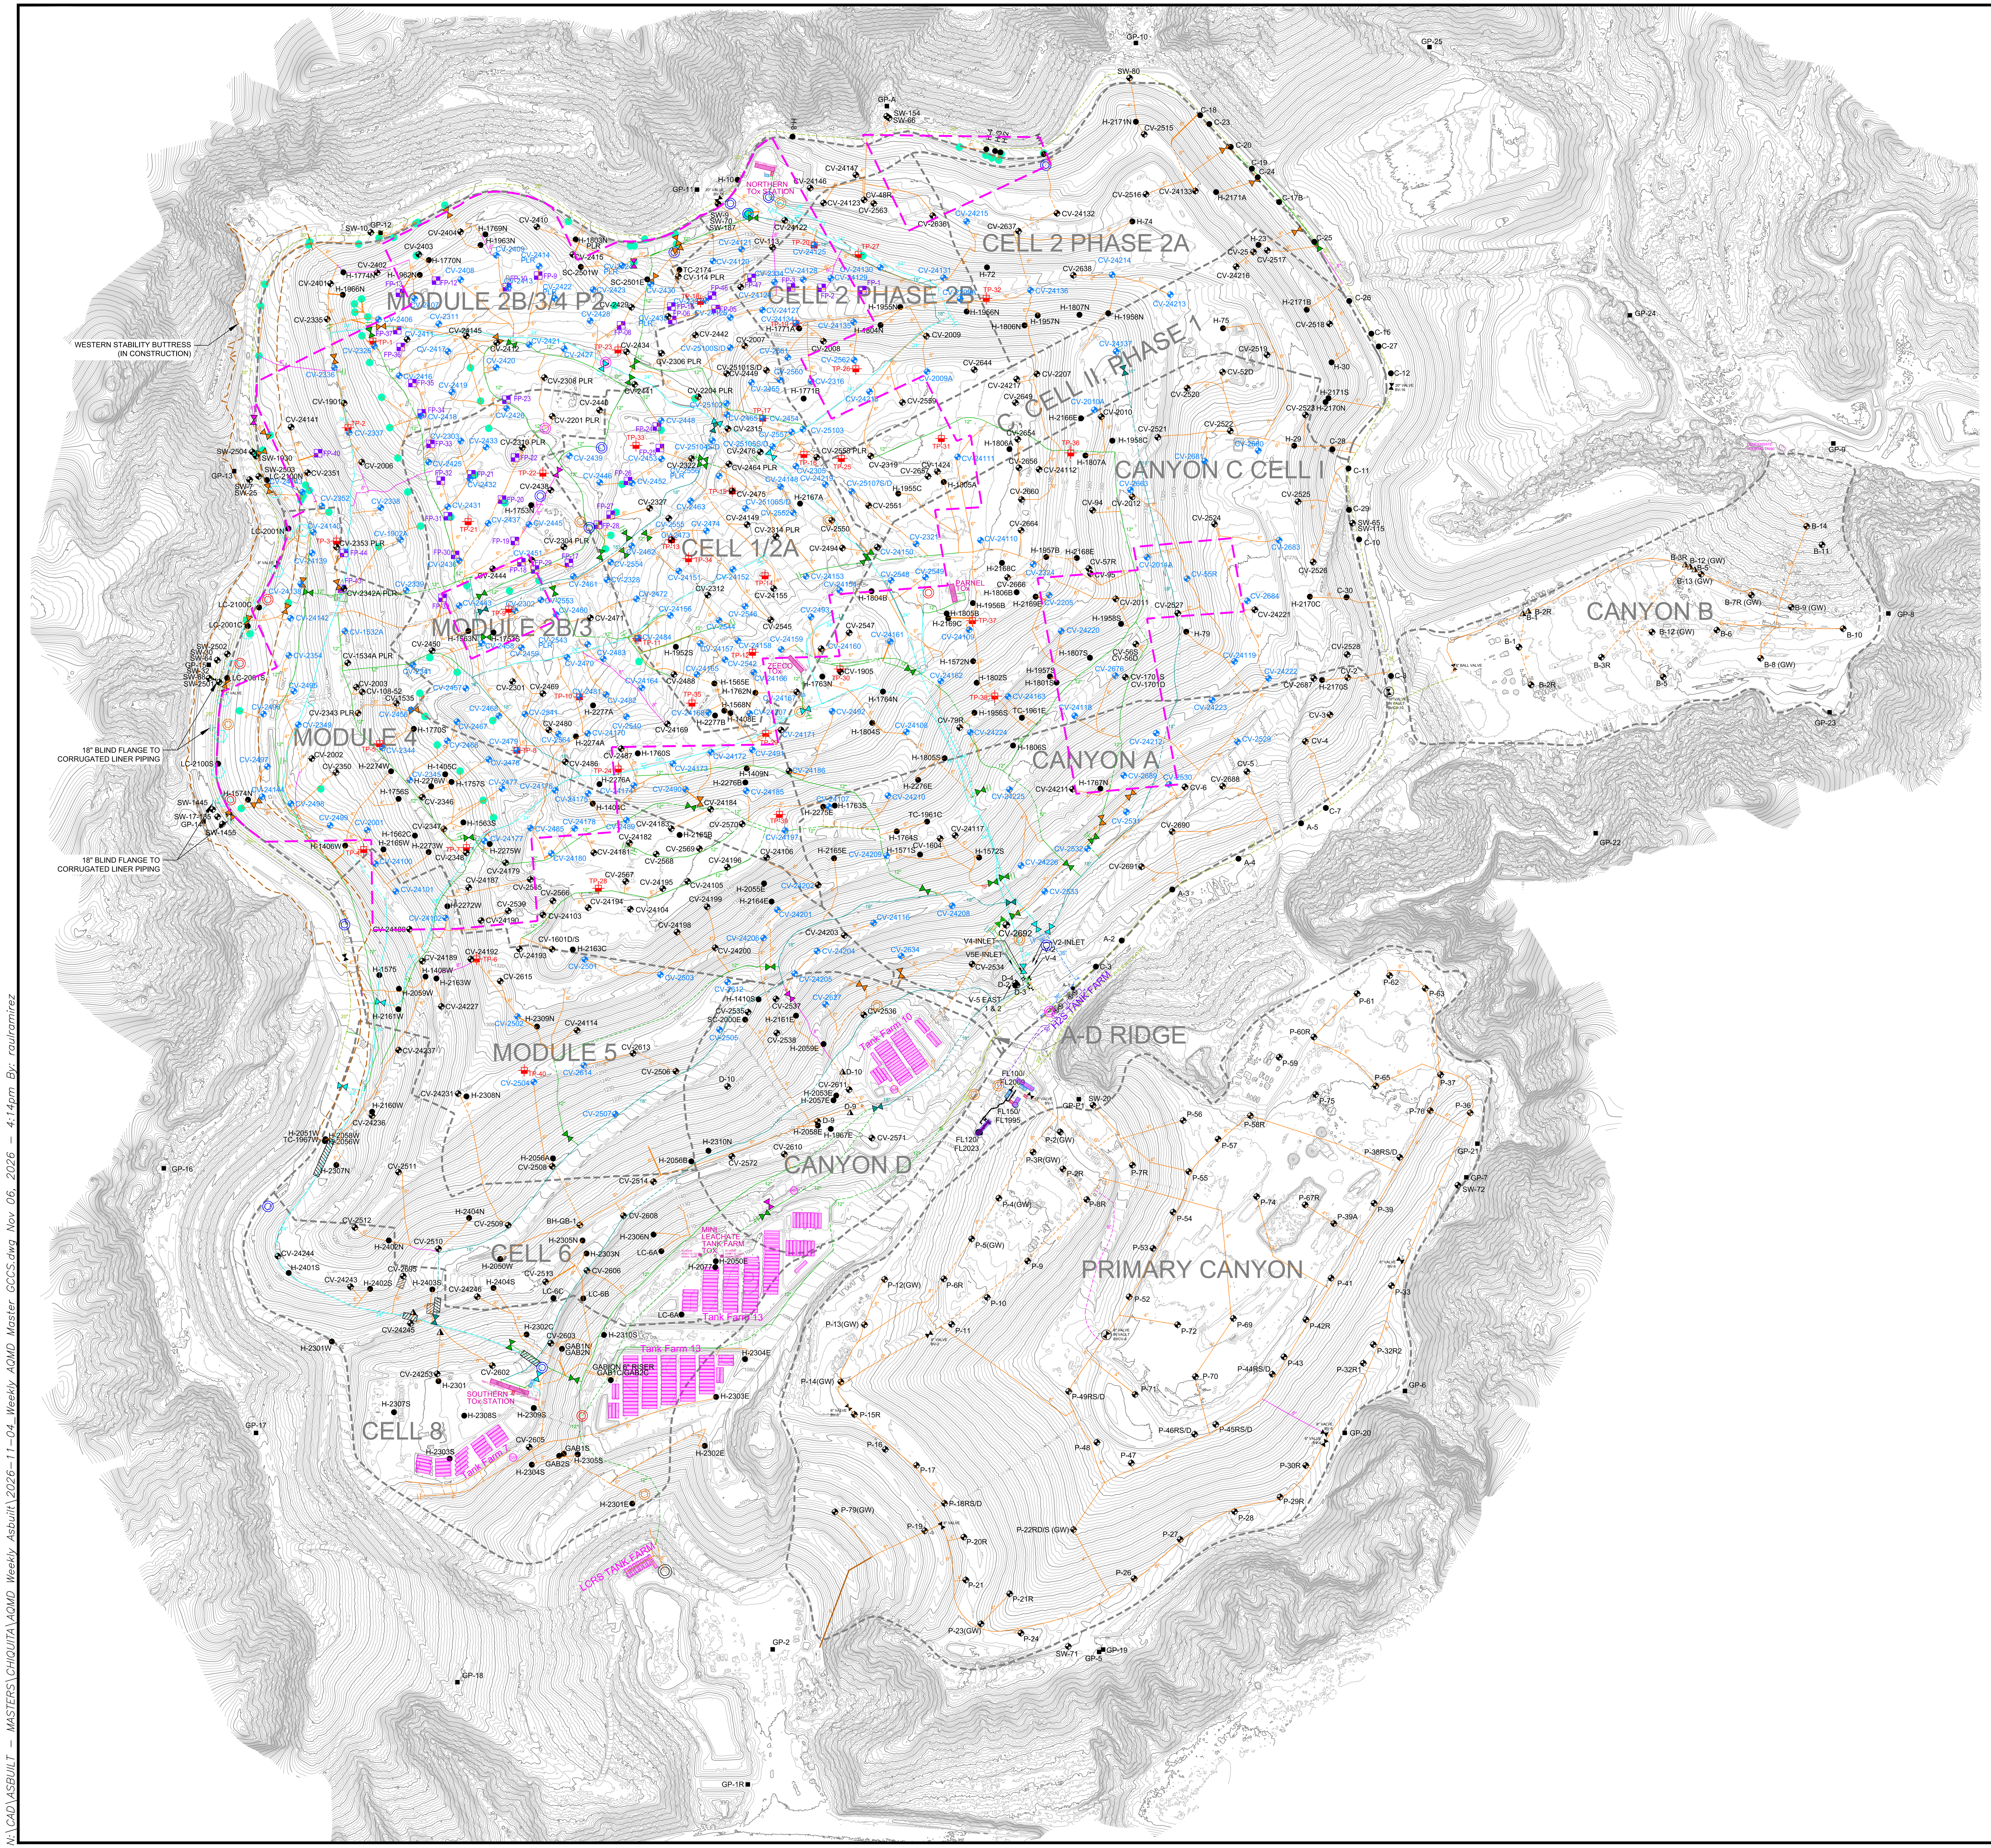


N

GRAPHIC SCALE

150 75 0 150 300 450

SCALE: 1"=150'

LEGEND

Symbol	Description
1150	TOPOGRAPHIC CONTOUR
	EXISTING CELL LIMITS (APPROXIMATE)
	WESTERN BUTRESS FILL LIMITS
	REACTION MITIGATION AREA BOUNDARY (APPROXIMATE) -BASED ON DATA REVIEW
36"	EXISTING 36" LFG COLLECTION HEADER PIPING
30"	EXISTING 30" LFG COLLECTION HEADER PIPING
24"	EXISTING 24" LFG COLLECTION HEADER PIPING
20"	EXISTING 20" LFG COLLECTION HEADER PIPING
18"	EXISTING 18" LFG COLLECTION HEADER PIPING
12"	EXISTING 12" LFG COLLECTION HEADER PIPING
10"	EXISTING 10" LFG COLLECTION HEADER PIPING
8"	EXISTING 8" LFG COLLECTION LATERAL PIPING
4"/6"	EXISTING 4"/6" LFG COLLECTION LATERAL PIPING
	BELOW-GRADE PIPES ARE SHOWN DASHED
	EXISTING FRAC TANKS
	EXISTING TOx UNITS
	EXISTING FLARE
	EXISTING BLOWER SKIDS
	EXISTING LFG CONTROL LOCATIONS
	EXISTING ACTIVATED CARBON VESSEL
	EXISTING HDPE LINER RISER
	EXISTING CORRUGATED LINER RISER
CV/B/D/P-XX	EXISTING LFG VERTICAL EXTRACTION WELL - MAIN CANYON, CANYON B, D, PRIMARY CANYON
CV-XX PLR	EXISTING LFG VERTICAL EXTRACTION WELL - PRESSURIZED LEACHATE RELEASE
BH-GB	EXISTING GABION LFG COLLECTOR WELL
SW-XX	EXISTING SOIL VAPOR EXTRACTION WELL
FP-XX	EXISTING SURFACE COLLECTOR WELLHEAD
H/TC/SC-XX	EXISTING HORIZONTAL, TRENCH, SLOPE, OR COLLECTOR WELL
C-XX	EXISTING REMOTE VERTICAL WELLHEAD
GP-XX	EXISTING PERIMETER MIGRATION PROBE
TP-XX	EXISTING TEMPERATURE PROBE
	EXISTING ISOLATION VALVE
	EXISTING BLIND FLANGE
	EXISTING LFG END CAP
SP	EXISTING SAMPLE POINT
CV-XX	EXISTING LFG VERTICAL EXTRACTION WELL - WITH PUMP
	EXISTING CONDENSATE SUMP - WITH NO PUMP
	EXISTING CONDENSATE SUMP - WITH ONE PUMP
	EXISTING CONDENSATE SUMP - WITH TWO PUMPS
	EXISTING CONDENSATE SUMP - WITH THREE PUMPS

GENERAL DRAWING NOTES:

1. EXISTING GCCS AS-BUILT DATED NOVEMBER 06, 2026.
2. EXISTING TOPOGRAPHIC SURVEY INFORMATION SHOWN WAS PROVIDED BY PROPELLER AERIAL PHOTOGRAPHY DATED OCTOBER 28, 2026.
3. APPROXIMATED REACTION MITIGATION AREA BOUNDARY ADJUSTMENTS DATED OCTOBER 10, 2026, BASED ON SEPTEMBER 2026 DATA.
4. NORTH ARROW SHOWN HERE IS REFERENCE TO THE CALIFORNIA STATE PLANE ZONE V COORDINATE SYSTEM, NAD 83.
5. THE LOCATION OF ANY EXISTING PIPING, VALVES, TIE-IN LOCATIONS AND OTHER FEATURES ARE APPROXIMATE AND SHOULD BE USED FOR INFORMATION PURPOSES ONLY. ACTUAL FIELD CONDITIONS MAY VARY AND ARE SUBJECT TO CHANGE BASED ON TOPOGRAPHIC FEATURES AND SITE-SPECIFIC FACTORS.

NO.	REVISION	DATE

SHEET TITLE: EXISTING GCCS MASTER AS-BUILT MAP

PROJECT TITLE: CHIQUITA CANYON LANDFILL CASTAIC, CALIFORNIA

CLIENT: CHIQUITA CANYON LANDFILL CASTAIC, CALIFORNIA

SCS ENGINEERS
ENVIRONMENTAL CONSULTANTS
3900 KILROY AIRPORT WAY, SUITE 300
LONG BEACH, CA 90806
PH. (562) 426-9544

PROJ. NO. 01204123.45 | DSN. BY: RNH | DWN. BY: RR | CHK. BY: RNH | ACAD FILE: N://CAD/ASBUILT-MASTERS | APP. BY: RNH

DATE: 11/06/2026

SCALE: AS SHOWN

N:\CAD\ASBUILT – MASTERS\CHIQUITA\AQMD Weekly Asbuilt\2026-11-04_Weekly AQMD Master GCCS.dwg Nov 06, 2026 – 4:14pm By: raulramirez