From:	Medina, Steven <SMedina@scsengineers.com>
Sent:	Friday, November 13, 2026 1:35 PM
To:	Baitong Chen; Nathaniel Dickel; Christina Ojeda
Cc:	Huber, Rachelle; Chris Fear; Viswanathan, Srividhya; Mark.Adams; Dylan Smith; Sarah Phillips; Bill Haley
Subject:	No. 6177-4 Stipulated Order for Abatement - Weekly Pump Installation and Operation Update
Attachments:	2026-11-13_CCLF_Existing De-Watering Well with Pump Map_V1.0.pdf

Hello All,

In accordance with Condition 65 of the Modified Stipulated Order, below is the summary of the installation and operation of dewatering pumps for the Chiquita Canyon Landfill. This information is subject to change based on further review and verification.

During 11/06/2026 to 11/12/2026, Chiquita completed the installation of, and began operating during the day, sixteen (16) new pumps in a vertical LFG extraction well for a total of two-hundred-and-ten (210) pumps operating in vertical LFG extraction wells. Additionally, ten (10) pumps were taken offline last week, and sixteen (16) new pumps became operational, leading to a net increase of six (6) pumps. Please note that Chiquita has additional pumps in operation in perimeter sumps that are not included in this count.
During 11/13/2026 to 11/19/2026, given the number of dewatering pumps installed to date, and the maintenance associated with those pumps, Chiquita plans to install and begin operating five (5) additional pumps in vertical LFG extraction wells in locations along the north and south slope of the reaction area.

Regards,

SCS ENGINEERS

STEVEN Medina, E.I.T.
Project Professional
smedina@scsengineers.com
O: 858-583-7746
M: 858-204-4342
3900 Kilroy Airport Way, Suite #300
Long Beach, CA 90806

GENERAL DRAWING NOTES:

1. EXISTING GCCS VERTICAL WELL AS-BUILT DATED NOVEMBER 13, 2026.
2. EXISTING TOPOGRAPHIC SURVEY INFORMATION SHOWN WAS PROVIDED BY PROPELLER AERIAL PHOTOGRAPHY DATED NOVEMBER 11, 2026.
3. NORTH ARROW SHOWN IN REFERENCE TO CALIFORNIA STATE PLANE ZONE V COORDINATE SYSTEM, NAD 83.
4. APPROXIMATE REACTION MITIGATION AREA BOUNDARY DATED NOVEMBER 10, 2026, BASED ON OCTOBER WELLFIELD DATA, PER SOFA CONDITION 8(m) AS DEFINED IN 9A.
5. THE LOCATION OF ANY EXISTING GCCS COMPONENTS AND OTHER FEATURES ARE APPROXIMATE AND SHOULD BE USED FOR INFORMATION PURPOSES ONLY.

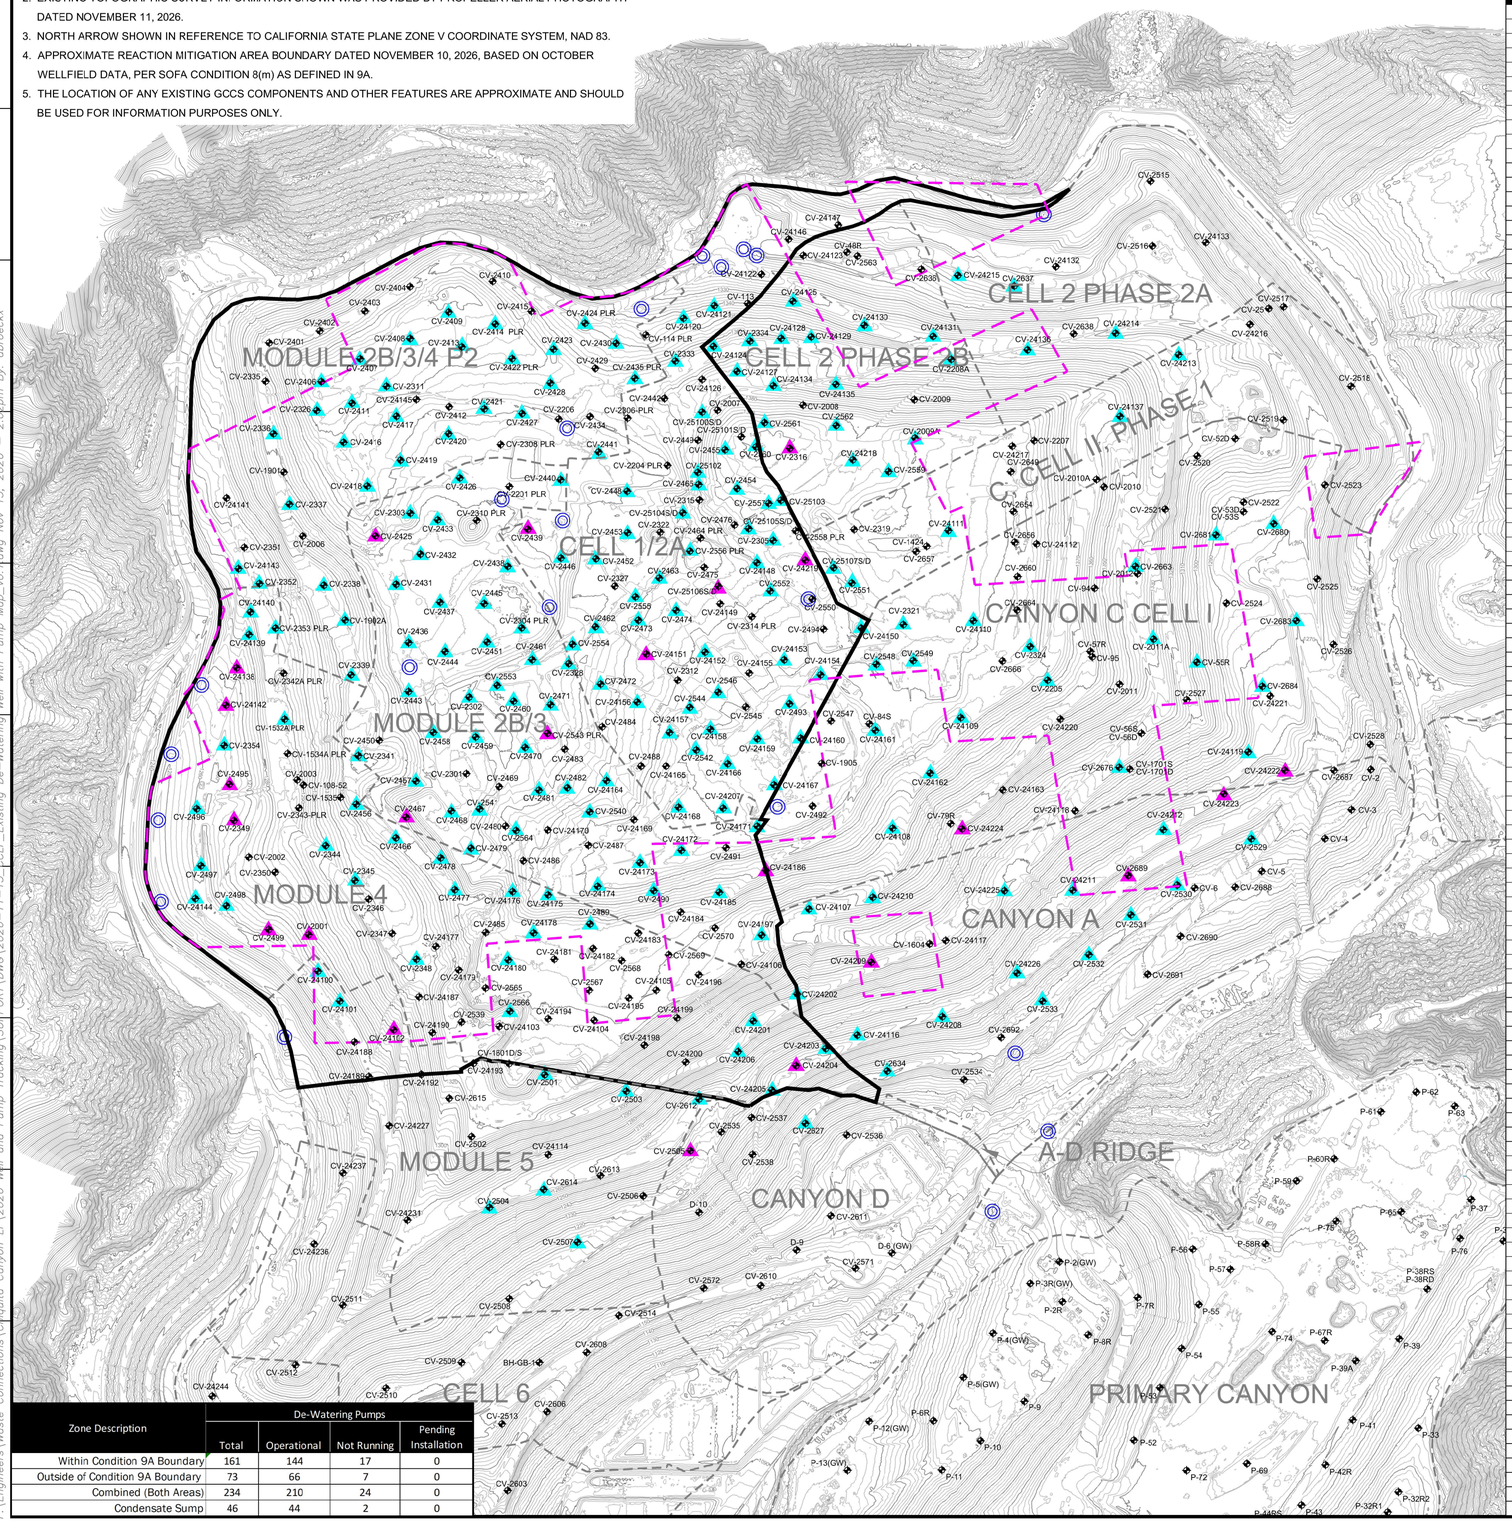

Zone Description	De-Watering Pumps			
	Total	Operational	Not Running	Pending Installation
Within Condition 9A Boundary	161	144	17	0
Outside of Condition 9A Boundary	73	66	7	0
Combined (Both Areas)	234	210	24	0
Condensate Sump	46	44	2	0

De-Watering Well Pumps Currently Running

#	Well I.D.	Install Date	#	Well I.D.	Install Date
1	CV-24110	7/17/2025	106	CV-2454	7/14/2026
2	CV-24120	8/8/2025	107	CV-2498	7/14/2026
3	CV-24180	8/15/2025	108	CV-25100D	7/14/2026
4	CV-2489	9/4/2025	109	CV-24100	7/15/2026
5	CV-24148	9/4/2025	110	CV-2501	7/17/2026
6	CV-2305	9/8/2025	111	CV-24107	7/18/2026
7	CV-2440	9/15/2025	112	CV-24108	7/19/2026
8	CV-2426	9/18/2025	113	CV-24109	7/20/2026
9	CV-2431	9/18/2025	114	CV-2564	7/21/2026
10	CV-2530	10/3/2025	115	CV-24111	7/22/2026
11	CV-55R	10/7/2025	116	CV-24116	7/23/2026
12	CV-24128	10/13/2025	117	CV-24119	7/26/2026
13	CV-2532	10/17/2025	118	CV-24124	7/30/2026
14	CV-2533	10/17/2025	119	CV-24125	7/31/2026
15	CV-2529	10/18/2025	120	CV-2507	8/3/2026
16	CV-2433	10/28/2025	121	CV-2560	8/3/2026
17	CV-2551	10/30/2025	122	CV-2556-PLR	8/6/2026
18	CV-2011A	11/24/2025	123	CV-24134	8/7/2026
19	CV-24215	11/24/2025	124	CV-2552	8/7/2026
20	CV-24164	12/11/2025	125	CV-24135	8/8/2026
21	CV-2461	12/17/2025	126	CV-24136	8/9/2026
22	CV-24156	12/17/2025	127	CV-2468	8/10/2026
23	CV-24157	12/18/2025	128	CV-24137	8/10/2026
24	CV-24158	12/19/2025	129	CV-24139	8/12/2026
25	CV-24152	12/22/2025	130	CV-2503	8/12/2026
26	CV-24153	1/5/2026	131	CV-24140	8/13/2026
27	CV-2352	1/26/2026	132	CV-2541	8/13/2026
28	CV-2458	2/5/2026	133	CV-25104D	8/14/2026
29	CV-1902A	3/5/2026	134	CV-24143	8/16/2026
30	CV-2205	3/13/2026	135	CV-24144	8/17/2026
31	CV-2208A	3/15/2026	136	CV-2542	8/18/2026
32	CV-2302	3/17/2026	137	CV-2408	8/19/2026
33	CV-24201	3/26/2026	138	CV-2428	8/19/2026
34	CV-2324	3/28/2026	139	CV-2421	8/20/2026
35	CV-2326	3/29/2026	140	CV-2333	8/21/2026
36	CV-24178	3/30/2026	141	CV-24150	8/21/2026
37	CV-2328	3/31/2026	142	CV-24129	8/25/2026
38	CV-2555	4/1/2026	143	CV-24154	8/25/2026
39	CV-2336	4/3/2026	144	CV-24159	8/30/2026
40	CV-24176	4/3/2026	145	CV-24160	8/31/2026
41	CV-2337	4/4/2026	146	CV-24161	9/1/2026
42	CV-2338	4/5/2026	147	CV-24162	9/2/2026
43	CV-2339	4/6/2026	148	CV-24218	9/2/2026
44	CV-2422-PLR	4/6/2026	149	CV-2419	9/3/2026
45	CV-2341	4/7/2026	150	CV-25102	9/4/2026
46	CV-2321	4/9/2026	151	CV-24166	9/6/2026
47	CV-2344	4/9/2026	152	CV-24167	9/7/2026
48	CV-2345	4/10/2026	153	CV-24168	9/8/2026
49	CV-2348	4/13/2026	154	CV-24171	9/11/2026
50	CV-2354	4/19/2026	155	CV-2549	9/11/2026
51	CV-2406	4/20/2026	156	CV-24172	9/12/2026
52	CV-2409	4/23/2026	157	CV-24173	9/13/2026
53	CV-2411	4/24/2026	158	CV-2680	9/13/2026
54	CV-2416	4/29/2026	159	CV-24174	9/14/2026
55	CV-2531	4/29/2026	160	CV-24175	9/15/2026
56	CV-2417	4/30/2026	161	CV-24121	9/17/2026
57	CV-2418	5/1/2026	162	CV-24130	9/17/2026
58	CV-2423	5/6/2026	163	CV-2557	9/18/2026
59	CV-2424-PLR	5/7/2026	164	CV-25103	9/21/2026
60	CV-2427	5/10/2026	165	CV-25105D	9/21/2026
61	CV-2430	5/12/2026	166	CV-2420	9/23/2026
62	CV-2432	5/14/2026	167	CV-24185	9/23/2026
63	CV-2436	5/18/2026	168	CV-24131	9/24/2026
64	CV-2437	5/19/2026	169	CV-2683	9/25/2026
65	CV-2438	5/20/2026	170	CV-2684	9/25/2026
66	CV-24127	5/21/2026	171	CV-2334	9/28/2026
67	CV-2443	5/25/2026	172	CV-24197	9/29/2026
68	CV-2444	5/26/2026	173	CV-2681	9/30/2026
69	CV-2445	5/27/2026	174	CV-24202	10/2/2026
70	CV-2446	5/28/2026	175	CV-24203	10/3/2026
71	CV-2448	5/29/2026	176	CV-24205	10/5/2026
72	CV-2451	6/1/2026	177	CV-2634	10/5/2026
73	CV-2456	6/1/2026	178	CV-2612	10/6/2026
74	CV-2453	6/3/2026	179	CV-24206	10/7/2026
75	CV-2303	6/5/2026	180	CV-24207	10/7/2026
76	CV-2455	6/5/2026	181	CV-24208	10/8/2026
77	CV-2457	6/7/2026	182	CV-2627	10/8/2026
78	CV-2459	6/9/2026	183	CV-24210	10/11/2026
79	CV-2460	6/10/2026	184	CV-24211	10/12/2026
80	CV-2462	6/12/2026	185	CV-24101	10/13/2026
81	CV-2463	6/13/2026	186	CV-24212	10/13/2026
82	CV-2465	6/15/2026	187	CV-2561	10/13/2026
83	CV-2466	6/16/2026	188	CV-24213	10/14/2026
84	CV-2474	6/16/2026	189	CV-24214	10/15/2026
85	CV-2477	6/16/2026	190	CV-2562	10/15/2026
86	CV-2553	6/17/2026	191	CV-2435	10/18/2026
87	CV-2482	6/18/2026	192	CV-24225	10/26/2026
88	CV-2544	6/18/2026	193	CV-2663	10/26/2026
89	CV-2546	6/18/2026	194	CV-24226	10/27/2026
90	CV-2470	6/20/2026	195	CV-2676	10/27/2026
91	CV-2471	6/21/2026	196	CV-2504	10/29/2026
92	CV-2472	6/22/2026	197	CV-2554	10/29/2026
93	CV-2473	6/23/2026	198	CV-2614	10/29/2026
94	CV-2540	6/23/2026	199	CV-2496	10/30/2026
95	CV-2548	6/25/2026	200	CV-2566	10/30/2026
96	CV-2478	6/28/2026	201	CV-2497	10/31/2026
97	CV-2479	6/29/2026	202	CV-25100S	11/3/2026
98	CV-2481	7/1/2026	203	CV-25107D	11/4/2026
99	CV-2414-PLR	7/3/2026	204	CV-1532A-PLR	11/9/2026
100	CV-2407	7/7/2026	205	CV-2304-PLR	11/10/2026
101	CV-2441	7/7/2026	206	CV-2413	11/10/2026
102	CV-2009A	7/10/2026	207	CV-2353	11/12/2026
103	CV-2311	7/10/2026	208	CV-2452	11/12/2026
104	CV-2490	7/10/2026	209	CV-2637	11/12/2026
105	CV-2493	7/13/2026	210	CV-2559	12/13/2026

De-Watering Well Pumps Currently Installed NOT RUNNING

#	Well I.D.	#	Well I.D.
1	CV-2001	13	CV-24186
2	CV-2316	14	CV-24204
3	CV-2349	15	CV-24209
4	CV-2425	16	CV-24219
5	CV-2439	17	CV-24222
6	CV-2467	18	CV-24223
7	CV-2495	19	CV-24224
8	CV-2499	20	CV-2505
9	CV-24102	21	CV-2543-PLR
10	CV-24138	22	CV-25106D
11	CV-24142	23	CV-25106S
12	CV-24151	24	CV-2689

GRAPHIC SCALE

200 100 0 200 400 600

SCALE: 1"=200'

LEGEND

- 1150 — TOPOGRAPHIC CONTOUR
- EXISTING CELL LIMITS (APPROXIMATE)
- REACTION MITIGATION AREA BOUNDARY - CONDITION 9A
- REACTION MITIGATION AREA BOUNDARY
- CV-XX — EXISTING VERTICAL EXTRACTION WELL
- CV-XX PLR — EXISTING VERTICAL EXTRACTION WELL - PRESSURIZED LEACHATE RELEASE
- EXISTING CONDENSATE SUMP - WITH PUMP
- EXISTING DE-WATERING WELL - PUMP INSTALLED AND RUNNING
- EXISTING DE-WATERING WELL - PUMP INSTALLED, NOT RUNNING

DATE | REVISION | NO.

SHEET TITLE: EXISTING DE-WATERING WELLS

PROJECT TITLE: CHIQUITA CANYON LANDFILL CASTAIC, CALIFORNIA

CLIENT: CHIQUITA CANYON LANDFILL CASTAIC, CALIFORNIA

SCS ENGINEERS
ENVIRONMENTAL CONSULTANTS
3900 KILROY AIRPORT WAY, SUITE 300
LONG BEACH, CA 90806
PH: (562) 426-9544

PROJ. NO. 01204123.45 | DSN. BY: - | DWN. BY: APB | CHK. BY: SRM | ACAD FILE: W:\CAD\ASBUILT-MASTERS | APP. BY: SRM

DATE: 11/13/2026

SCALE: AS SHOWN

SHEET: 1

F:\Engineers\Waste Connections\Chiquita Canyon LF\2026 Well and Pump Tracking\SUPPORT\DWG\2026-11-13_CCLF_Existing De-Watering Well with Pump Map_v0.1.dwg Nov 13, 2026 - 2:02pm By: abroeckx